

ROAD CLASSIFICATION


Heavy-duty		Light-duty	
Medium-duty		Unimproved dirt	
		U. S. Route	

MC KAY RESERVOIR, OREG.

N4530—W11845/7.5

1966

AMS 2275 III SE—SERIES V892

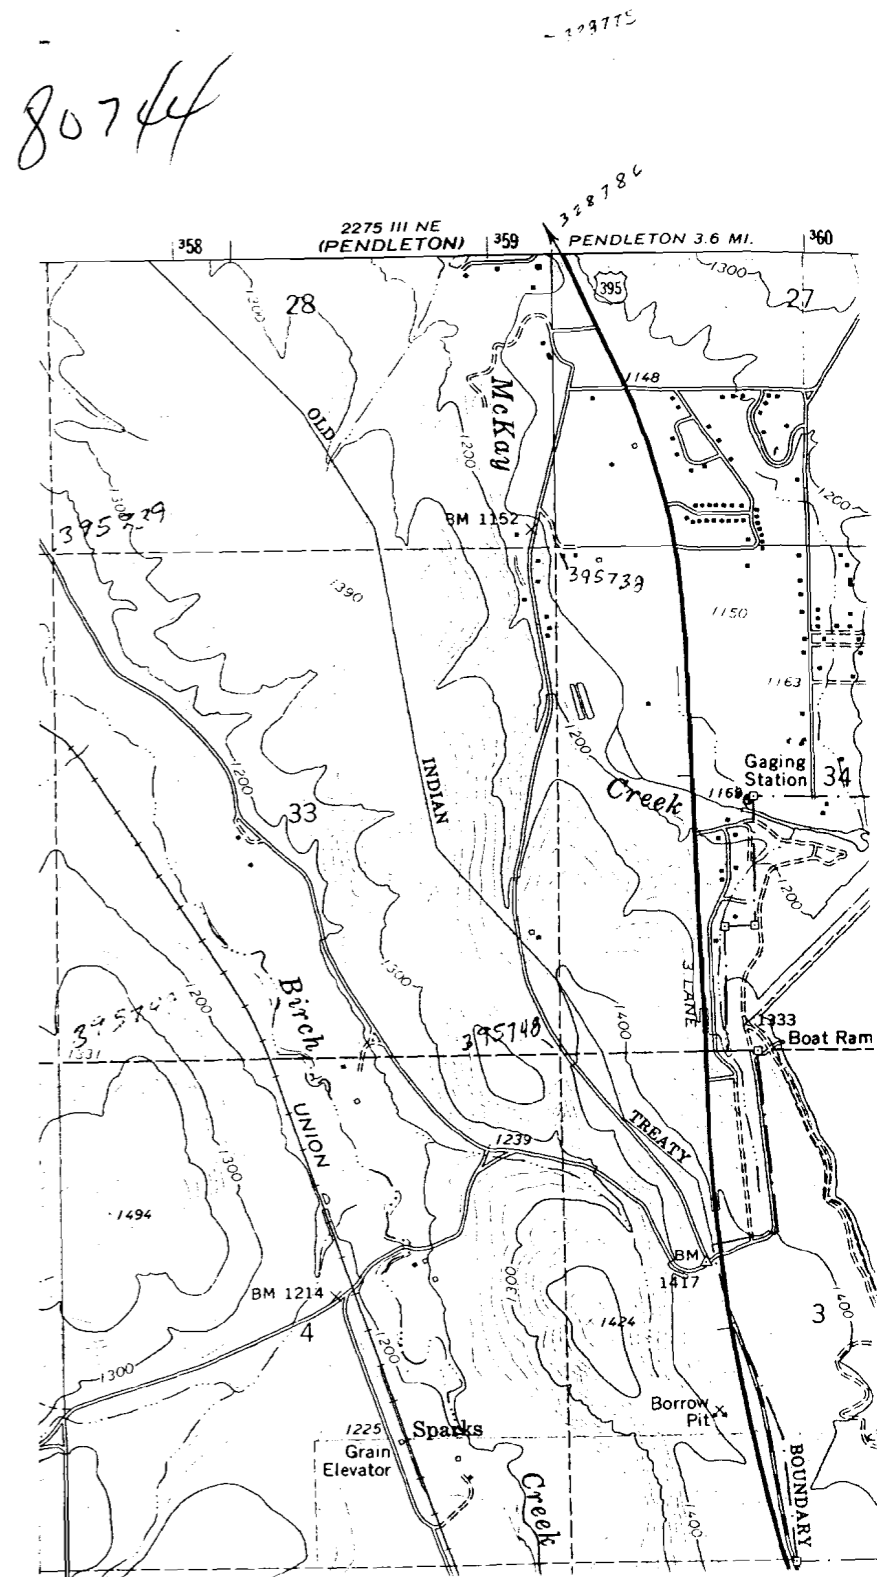

72075