CERTIFICATE NO. 72077

RECEIVED
JUL 27 1995
SALEM, OREGON

RECEIVED
DEC 29 1994
WATER RESOURCES DEPT.
SALEM, OREGON
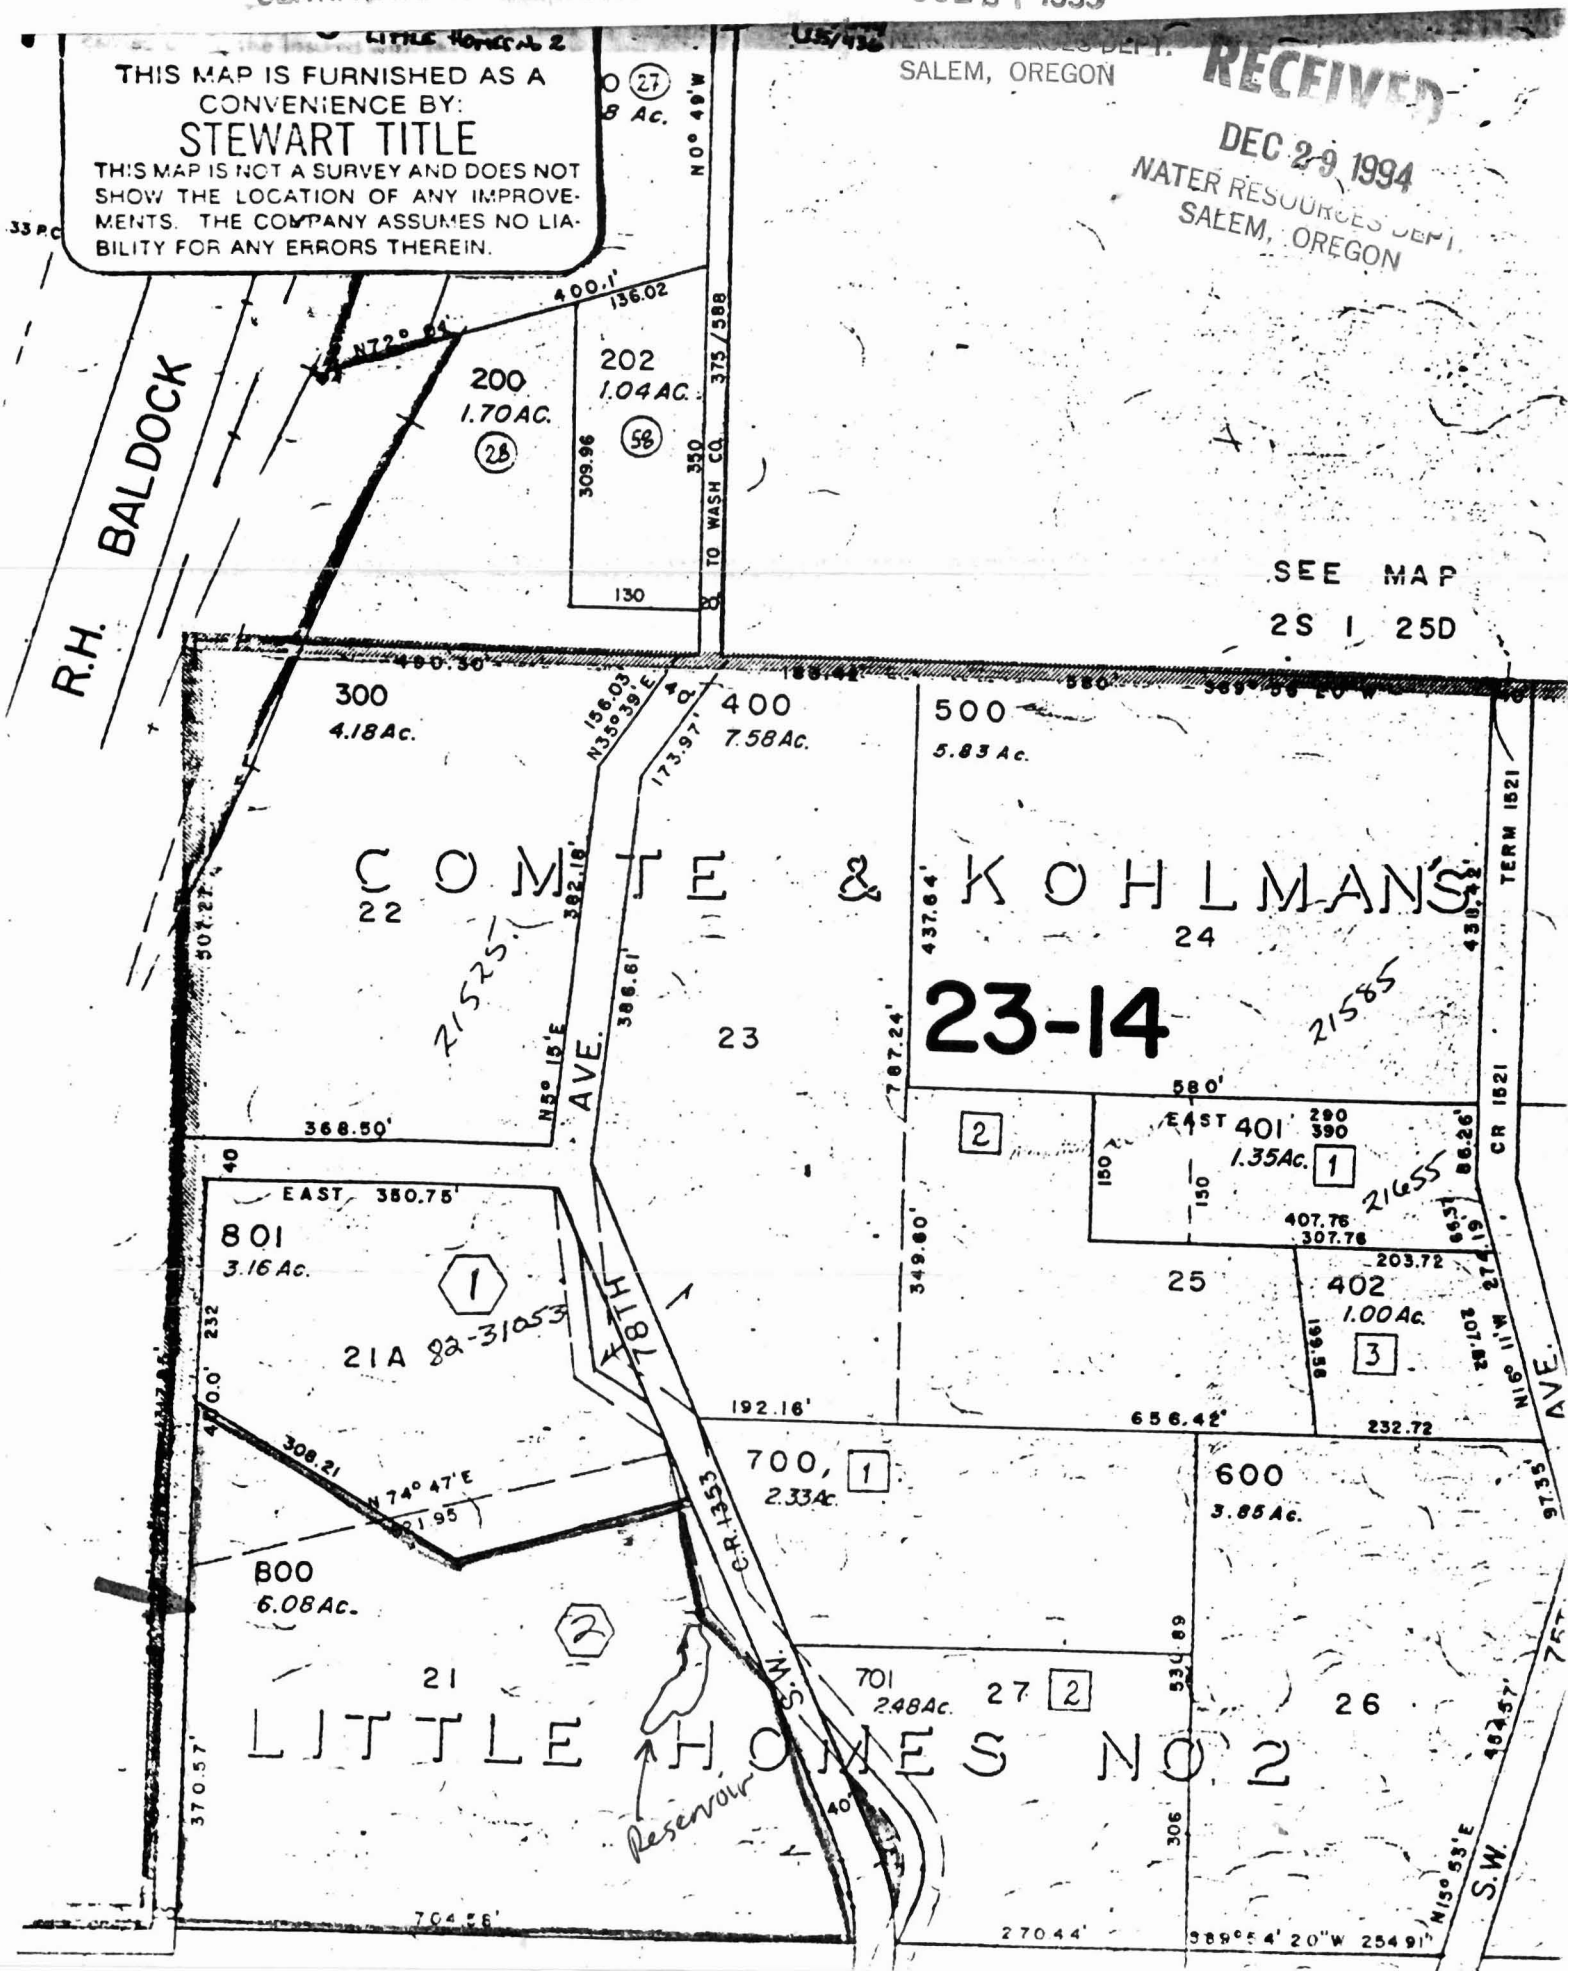
THIS MAP IS FURNISHED AS A CONVENIENCE BY:
STEWART TITLE
THIS MAP IS NOT A SURVEY AND DOES NOT SHOW THE LOCATION OF ANY IMPROVEMENTS. THE COMPANY ASSUMES NO LIABILITY FOR ANY ERRORS THEREIN.