


A-5731  
P-3607.

A-8254  
P-5866

Township 10 S

R

2131

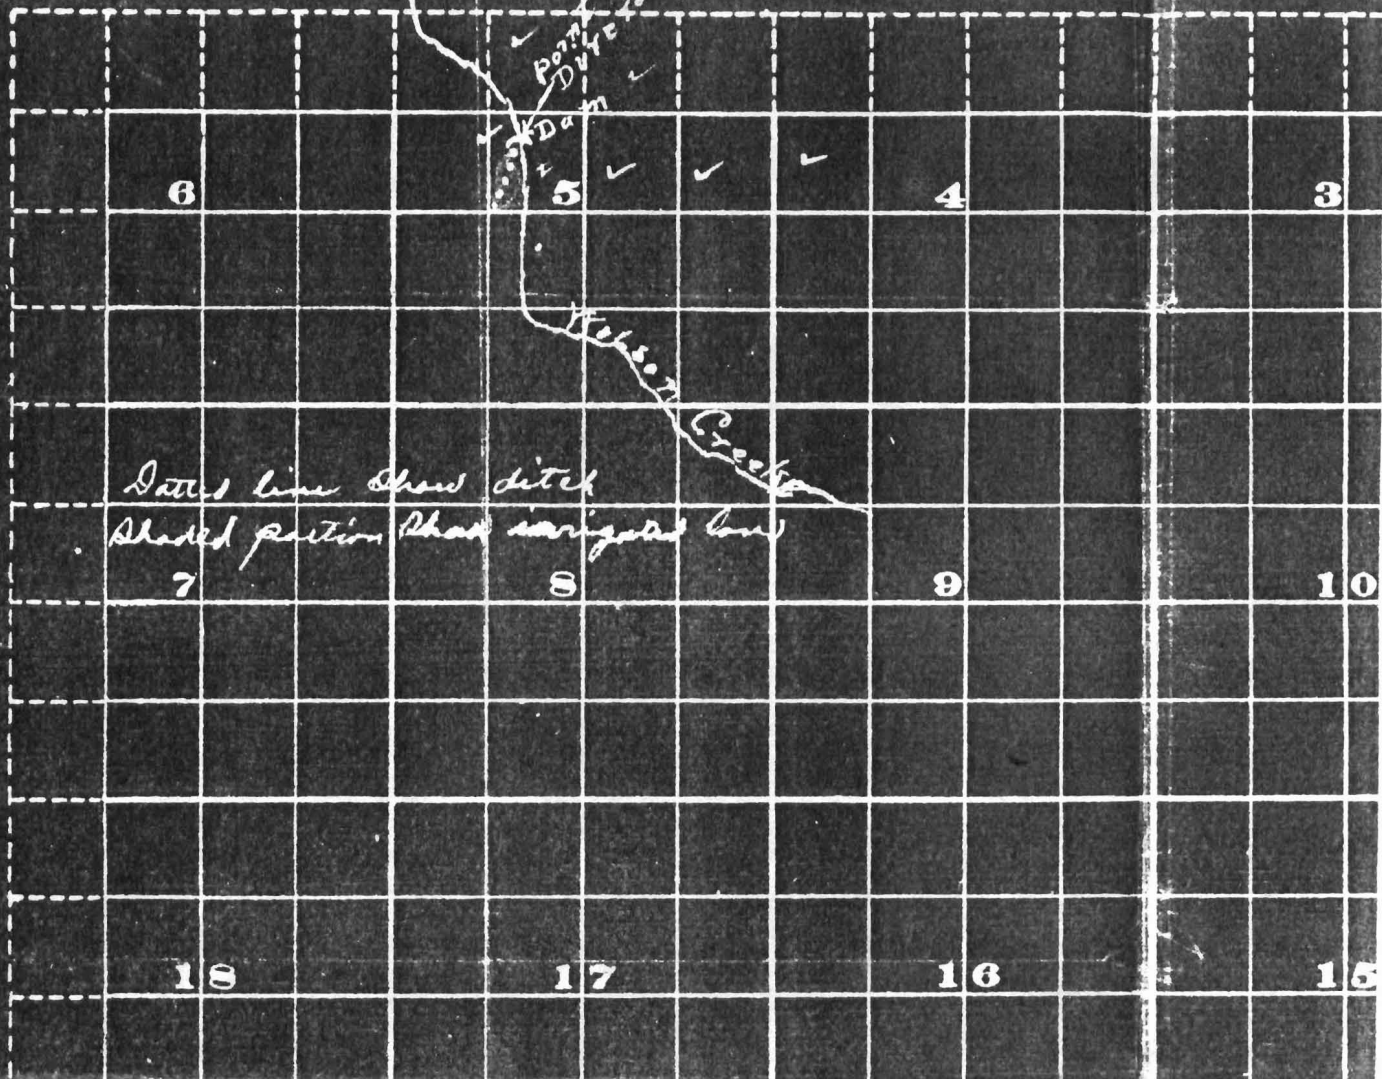

Township 10 S Range 15 E