

RECORDED

JUL 1 1995

WATER RESOURCES DEPT.
SALEM, OREGON

ASSESSMENT PURPOSE ONLY.

WALLOWA COUNTY

SEE MAP 02N 44 T-2000'

01N 44

WALLOWA

CANCELLED
PARCEL NO.'S

IN 44

900
3000
3501
3502
5801

SCALE 1:40000




INSERT
T-400'



SEE MAP 01N 45

INSERT
T-200'

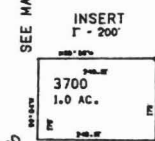

INSERT
T-200'



Application No. 280749
Permit No.

CERTIFICATE NO.

7-3

21-5

21-7

21-3

21-8

12-2

RECEIVED
MAR 04 1991
DEPT. OF LAND & FOREST
ASSESSMENT & APPRAISAL DIV.


RECEIVED

JUL 11 1995

SEE WATER RESOURCES DEPT.
SALEM, OREGON

RECEIVED
MAR 04 1991
OFFICE OF WATER RESOURCES
ASSESSMENT & APPROVAL DIV.

SCALE 1:70000
0 2000 4000
FEET

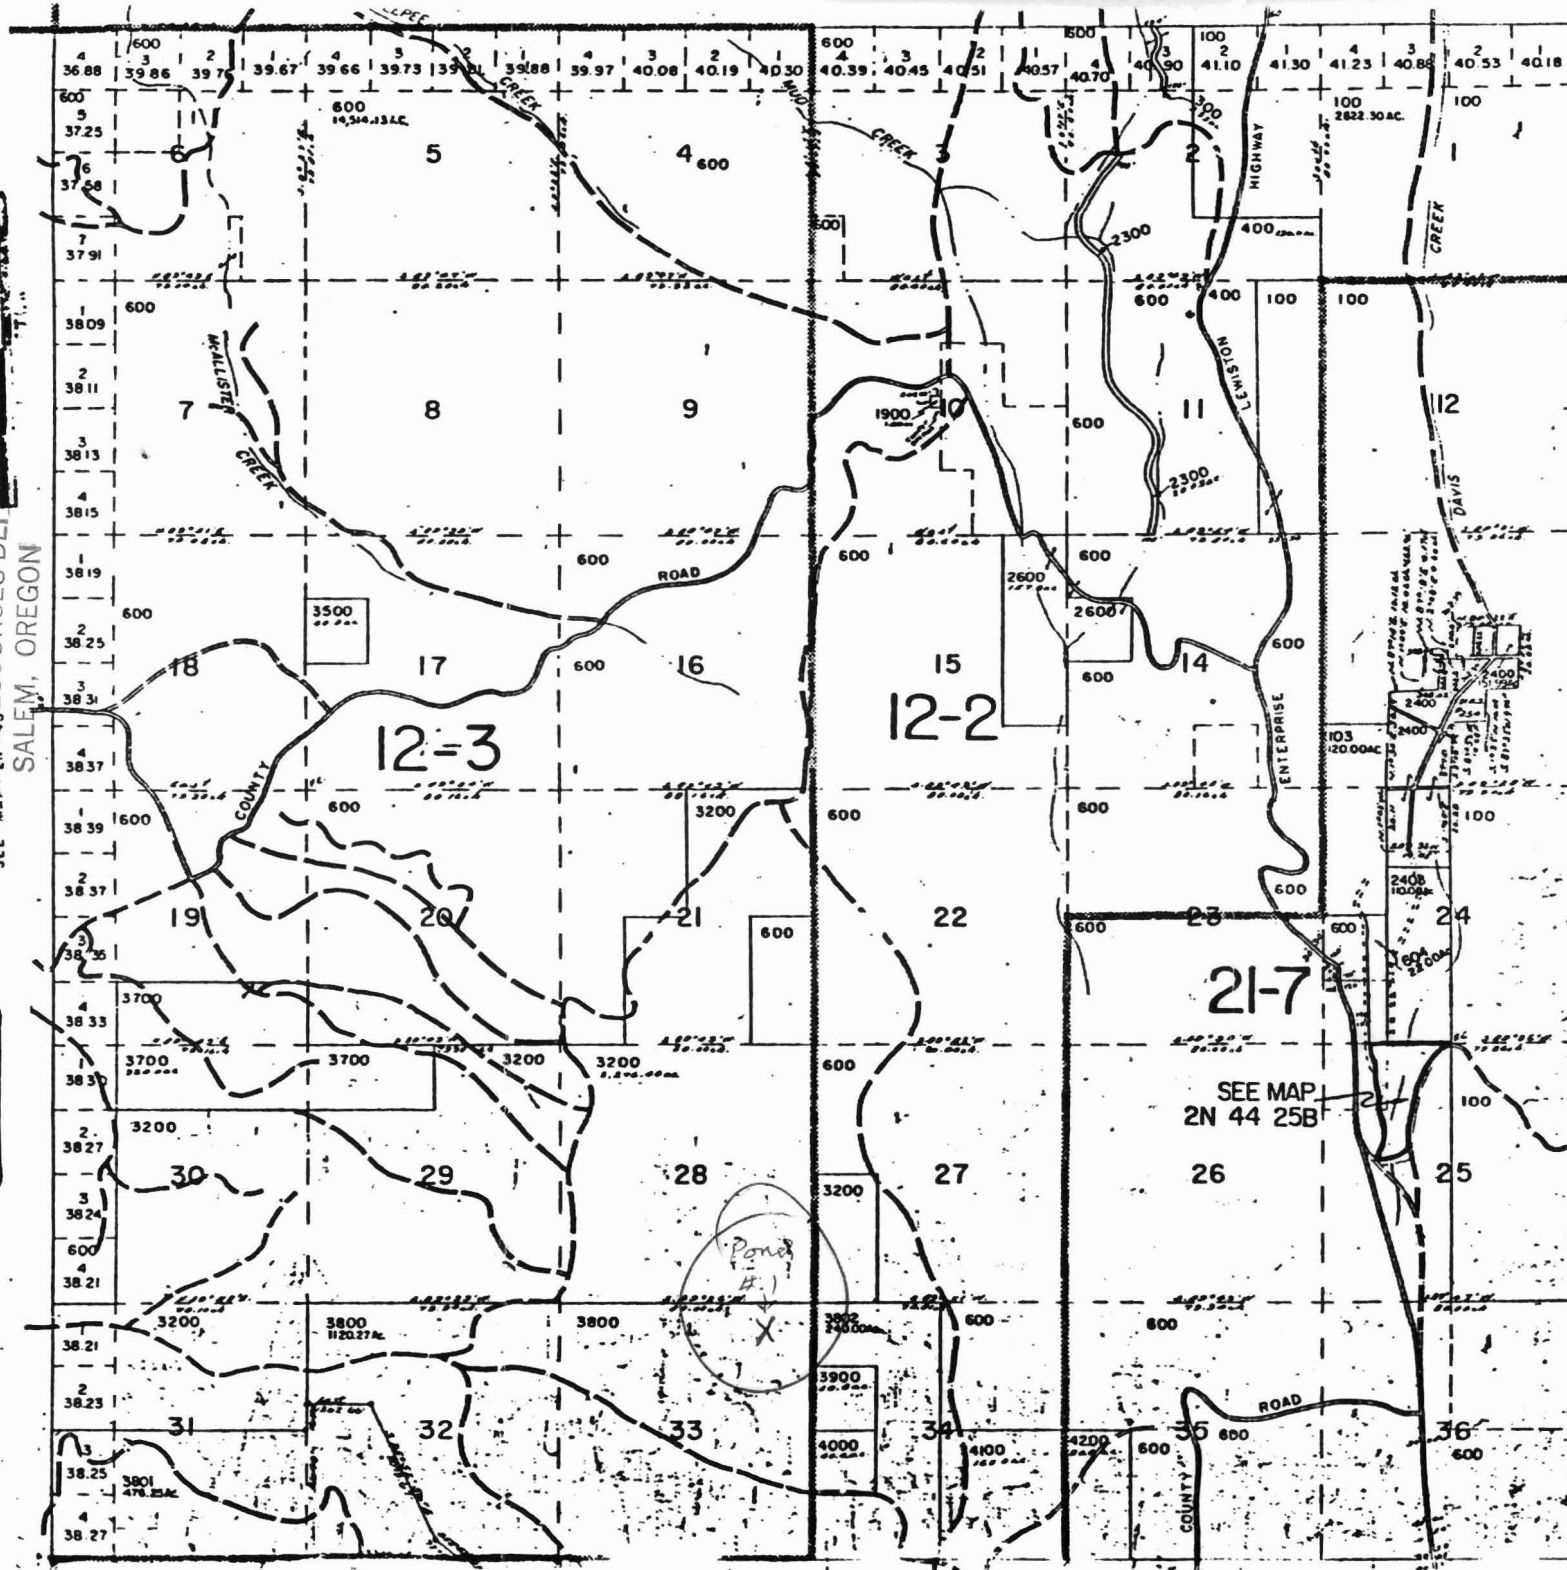

WALLA WALLA
CANCELLED NO. 2N 44
700
800
