

RECEIVED RECEIVED

JUN 29 1995

DEC 29 1994

CERTIFICATE NO.

72083

COUNTY


WATER RESOURCES DEPT.
SALEM, OREGON

WATER RESOURCES DEPT.
SALEM, OREGON

1/2 sec
shown by Hwy
18-38-25

John Creek

102
TL 2000' C
3300
700AI

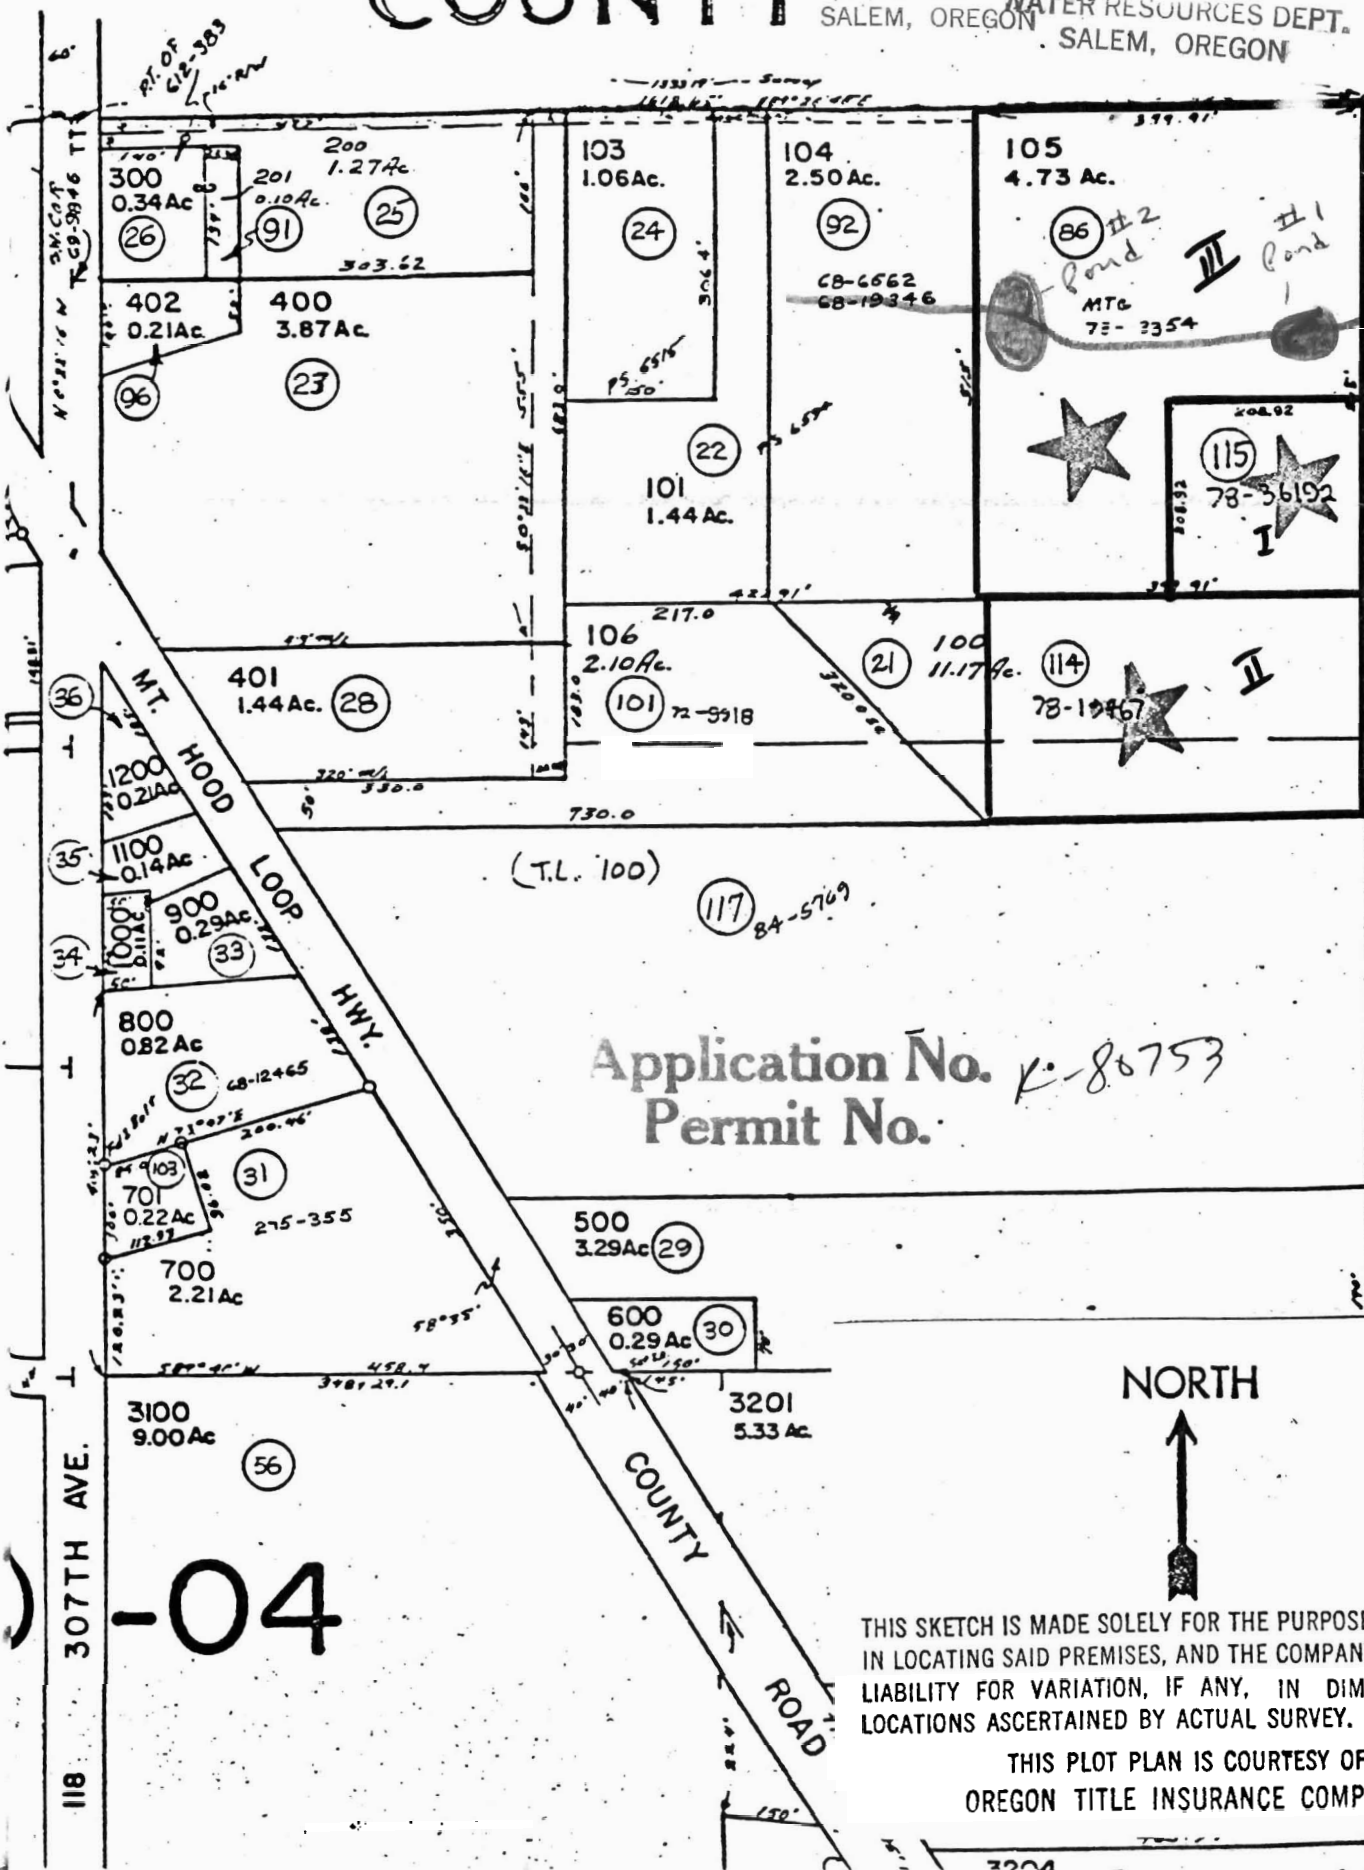

Application No. K-86753
Permit No.

NORTH

THIS SKETCH IS MADE SOLELY FOR THE PURPOSE OF ASSISTING
IN LOCATING SAID PREMISES, AND THE COMPANY ASSUMES NO
LIABILITY FOR VARIATION, IF ANY, IN DIMENSIONS AND
LOCATIONS ASCERTAINED BY ACTUAL SURVEY.

THIS PLOT PLAN IS COURTESY OF
OREGON TITLE INSURANCE COMPANY

AP 1 4E 29

-04

Application No. *P-80753*
Permit No.