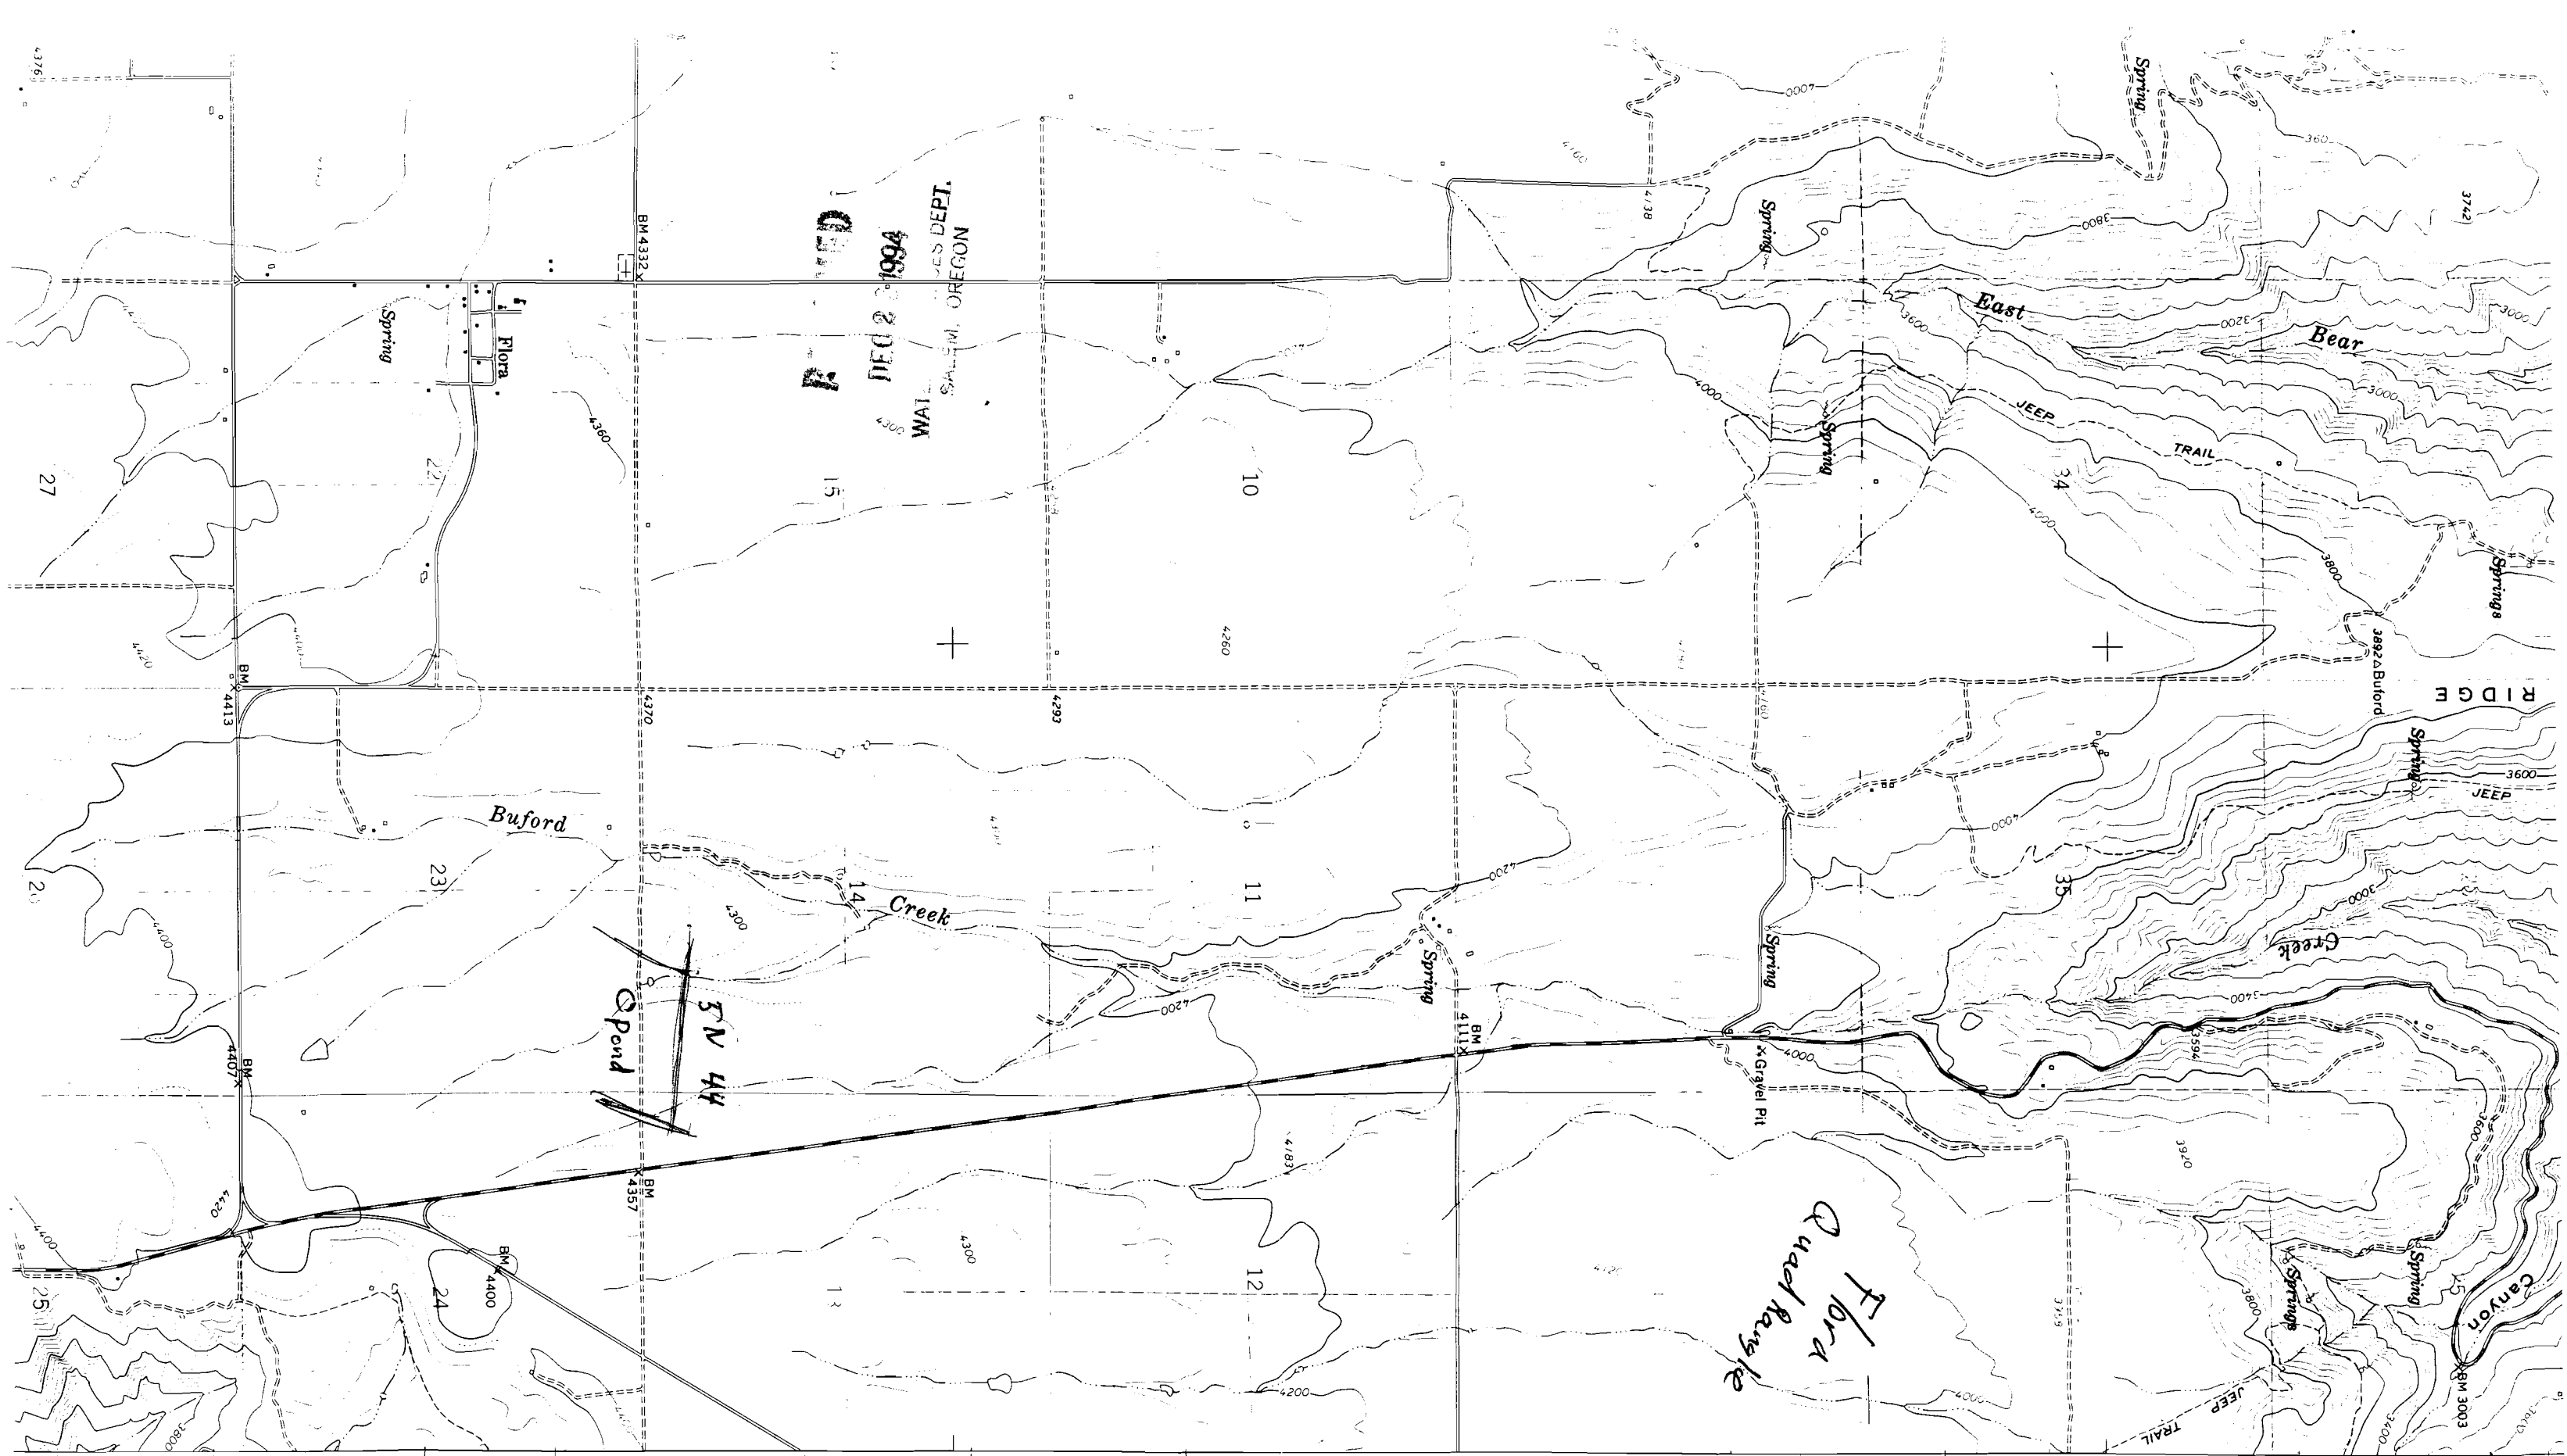

WATER RESOURCES DEPT.
SALEM, OREGON

CERTIFICATE NO. 72684

Application No. R-80780
Permit No.