


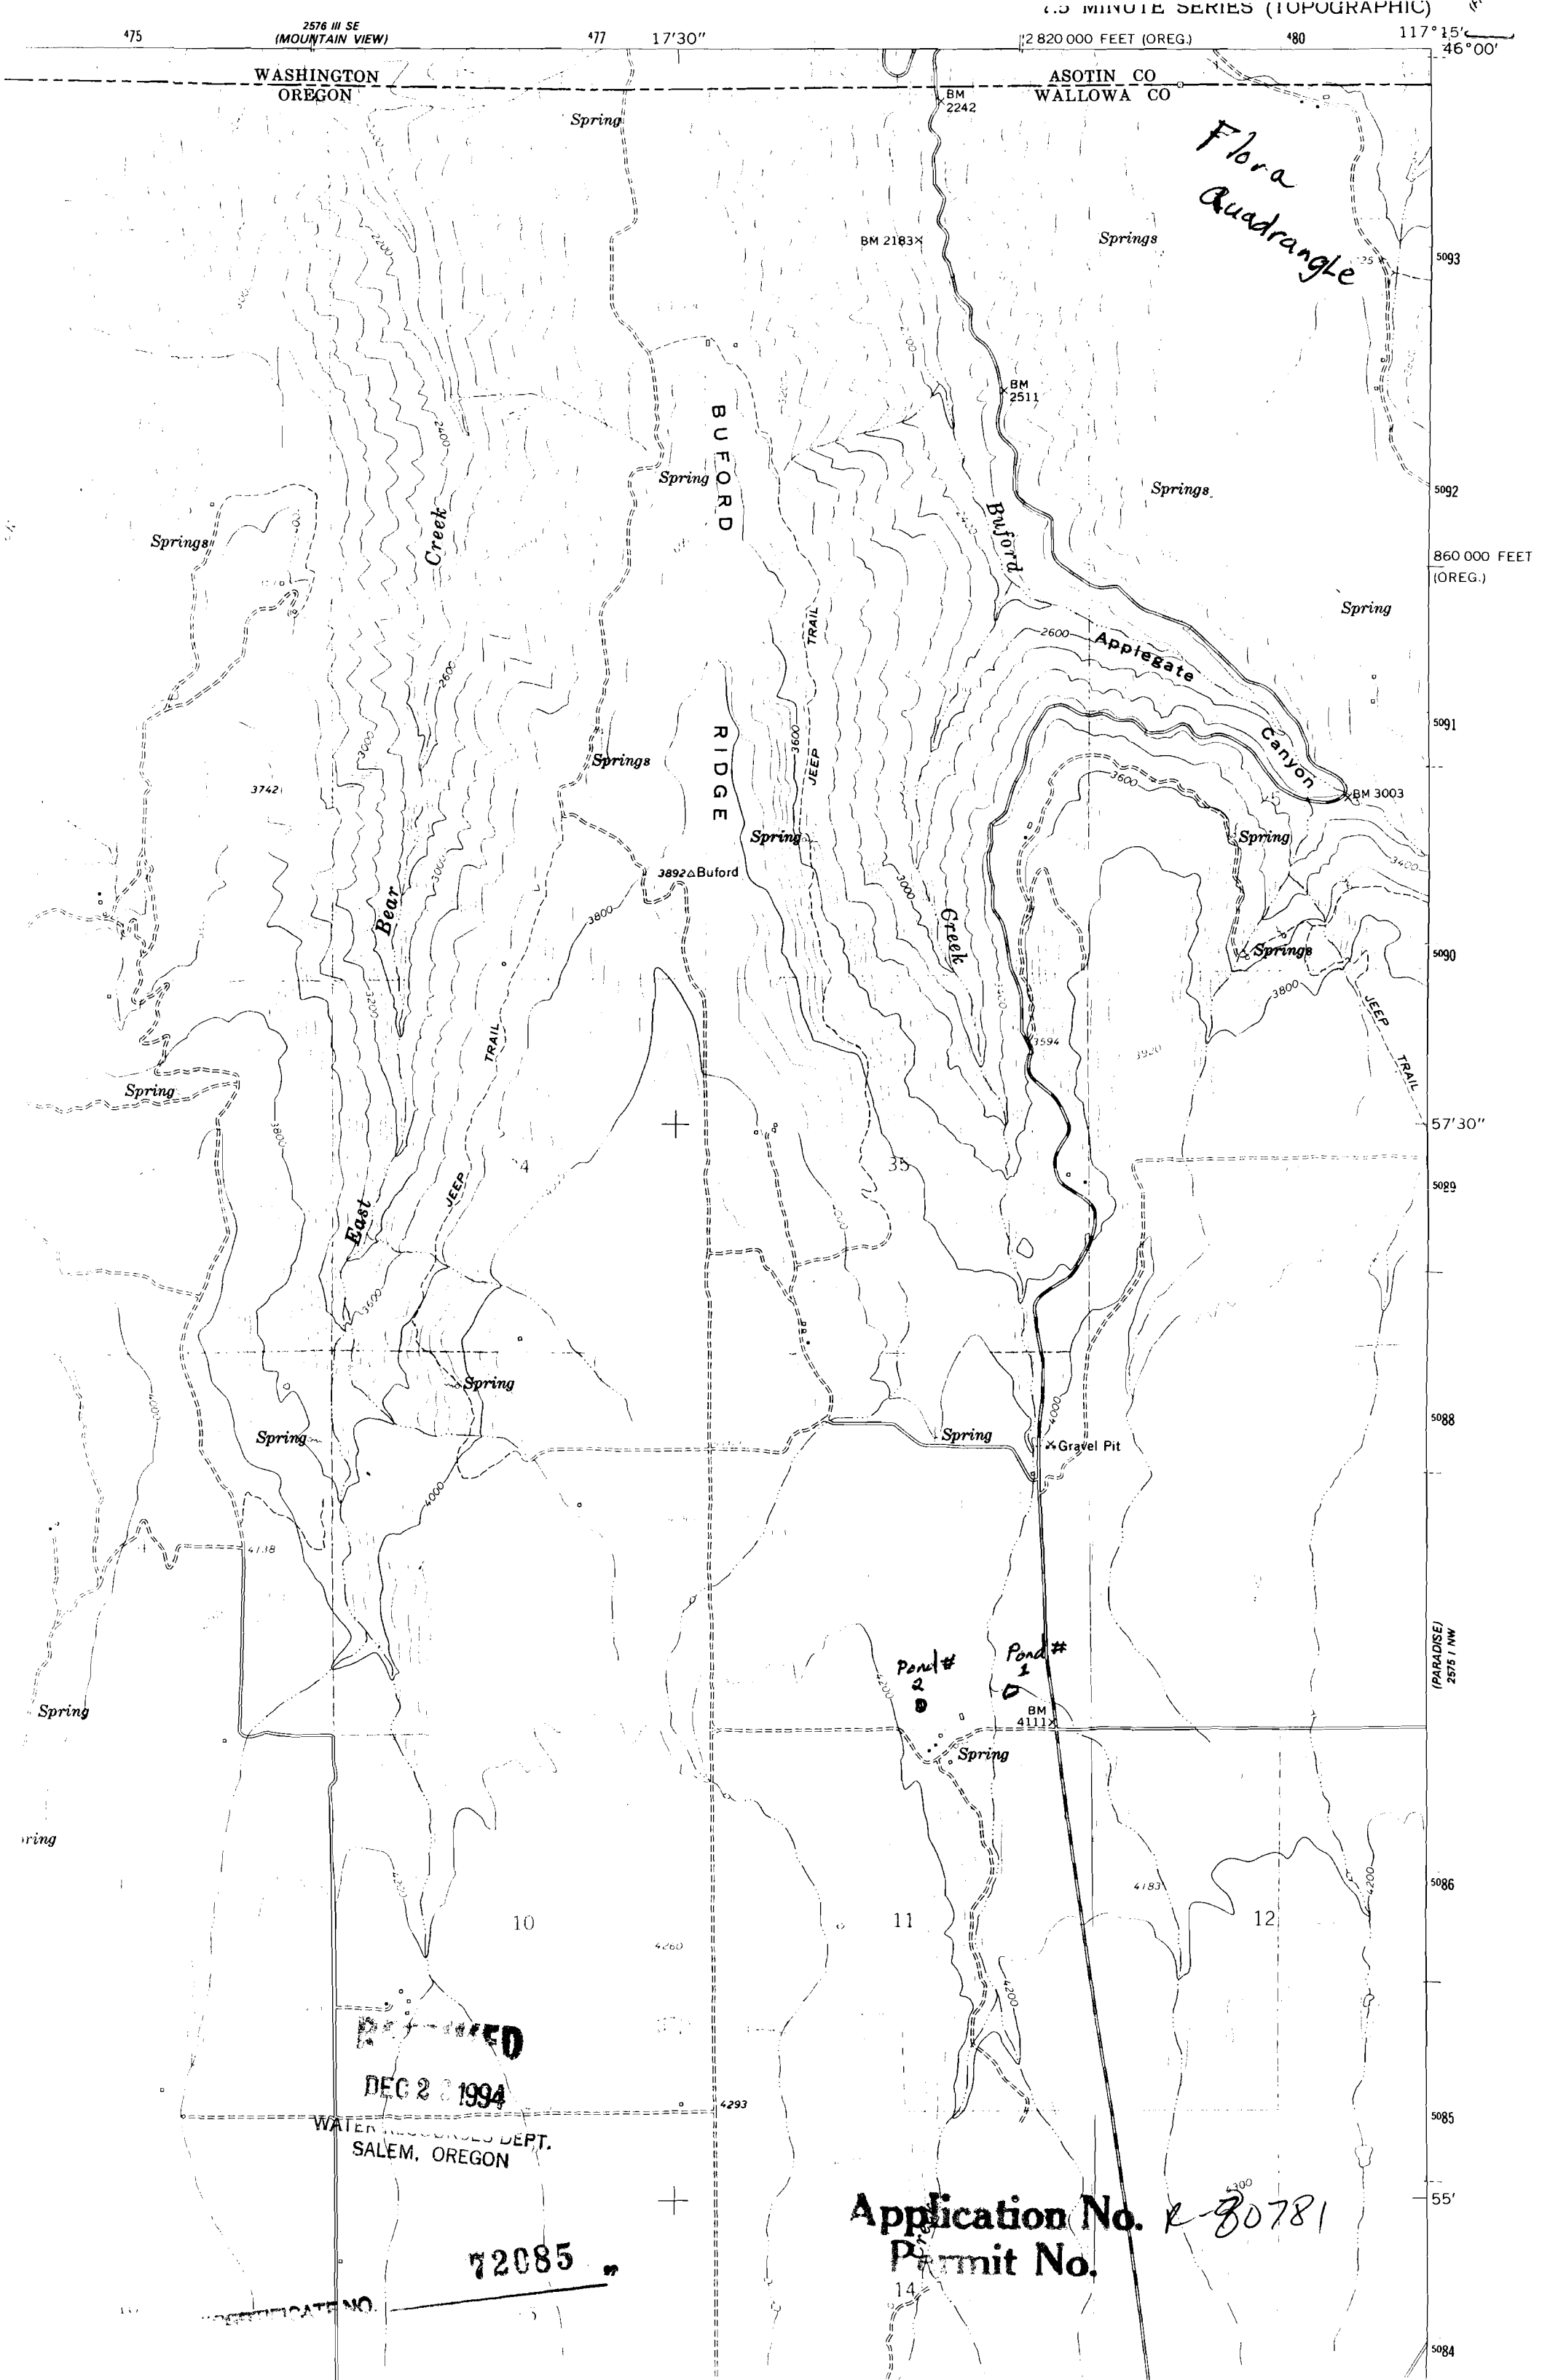

WASHINGTON
OREGON

ASOTIN CO
WALLOWA CO

Flora
Quadrangle

BUFORD
RIDGE

Applegate
Canyon

East
Bear
Creek

Buford
Creek

Creek

Pond #
2

Pond #
1

DEC 23 1994

WATER RESOURCES DEPT.
SALEM, OREGON

Application No. R-80781
Permit No.

72085

PERMIT NO.