


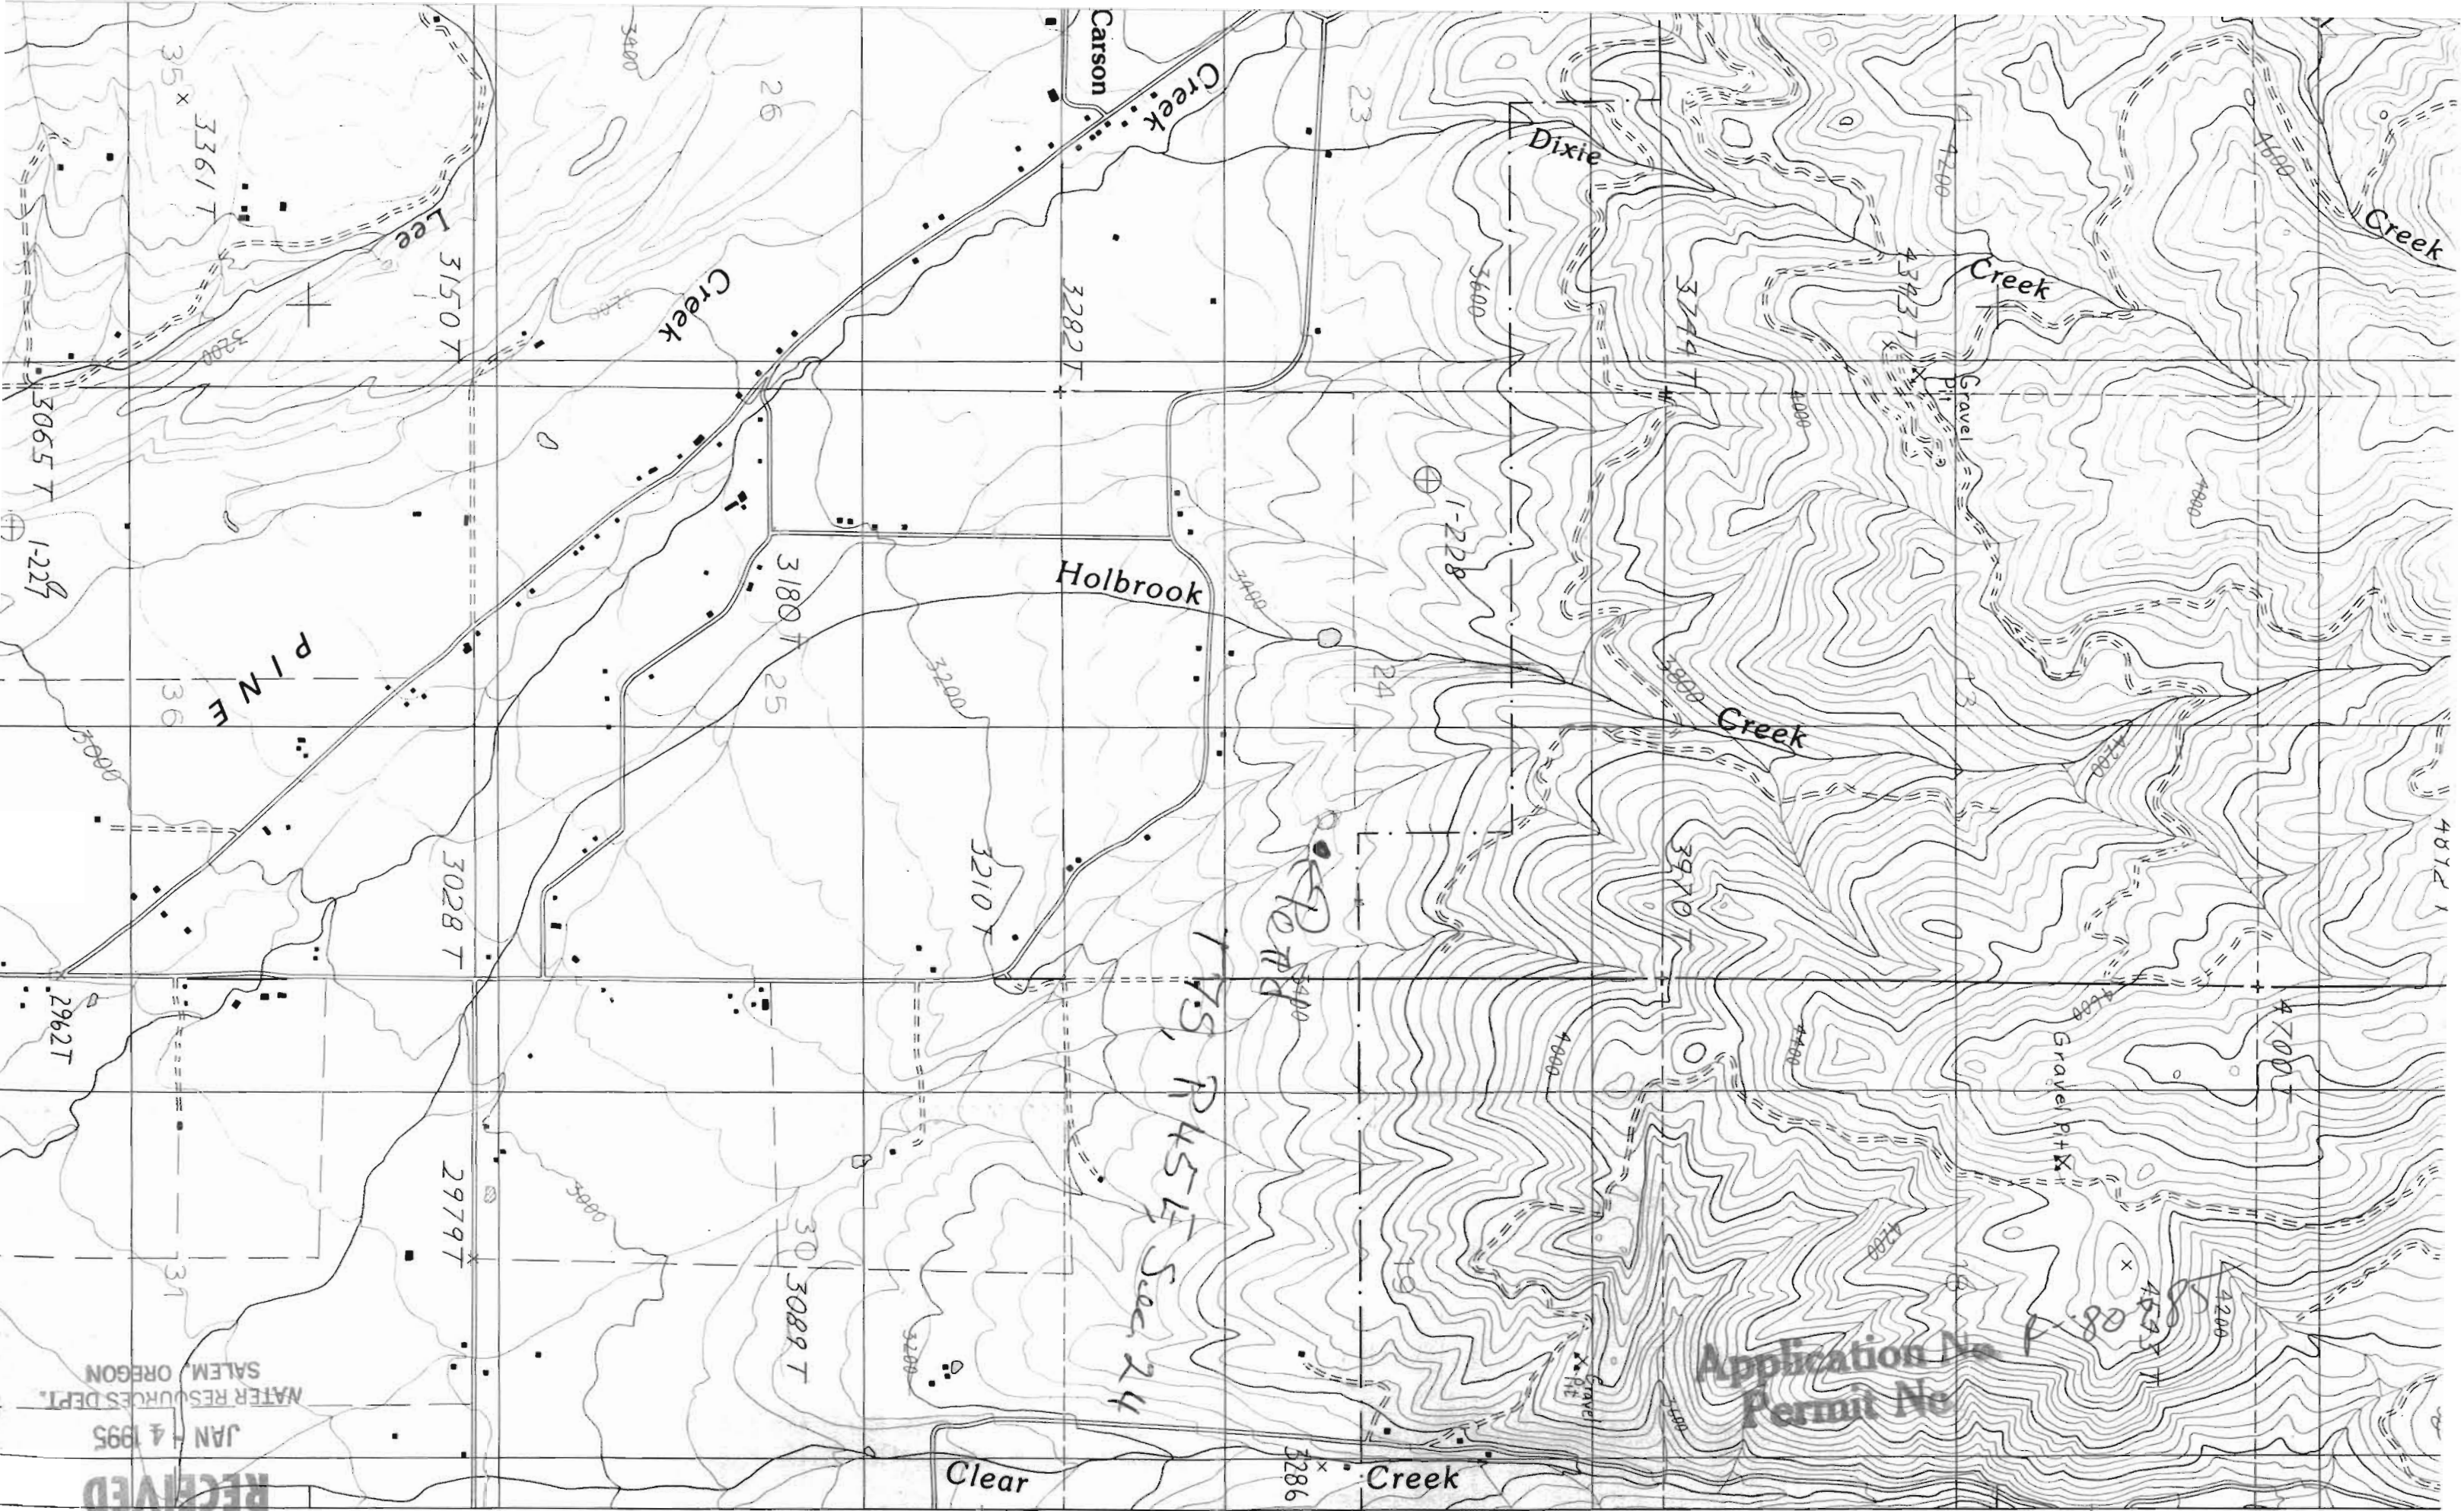

JAN 4 1995
WATER RESOURCES DEPT.
SALEM, OREGON

RECEIVED

175 P45E Sec 24

Application No.
Permit No.

Raymond L. Davidson
Rt. 1 Box 97 Halfway Or 97834 742-5280

"CONTINUED" NO. 72088