The sketch below is made solely for the purpose of assisting in locating said premises and the Company assumes no liability for variations, if any, in dimensions and location ascertained by actual survey.

TICOR TITLE INSURANCE
of California

RECEIVED
JAN - 9 1995
WATER RESOURCES DEPT.
SALEM, OREGON

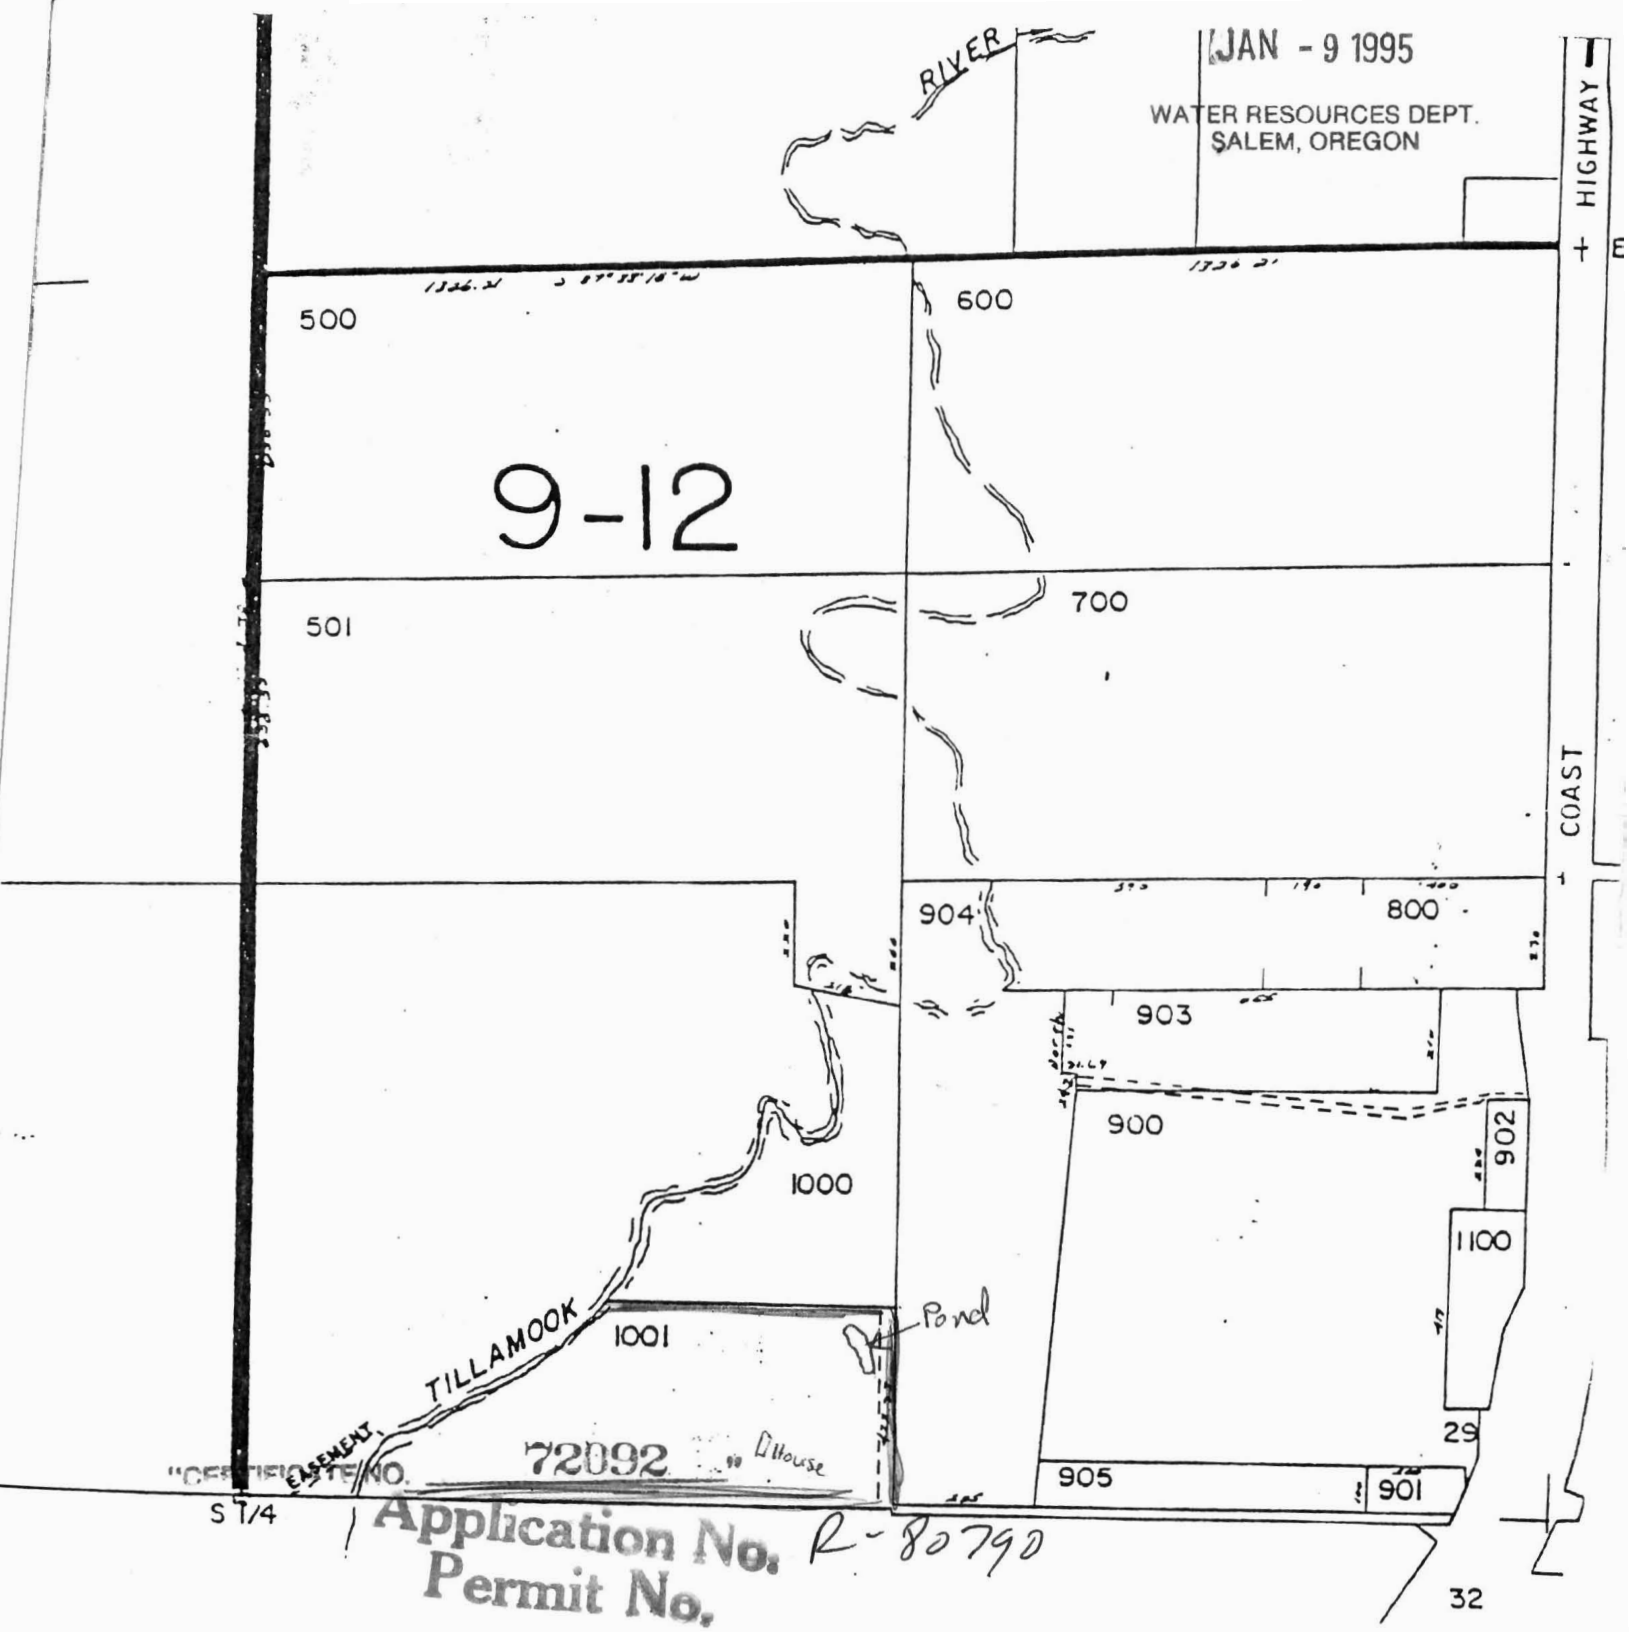

Application No. R-80790
Permit No.

SEE MAP 2S 9 32

RECEIVED JAN 03 1995