


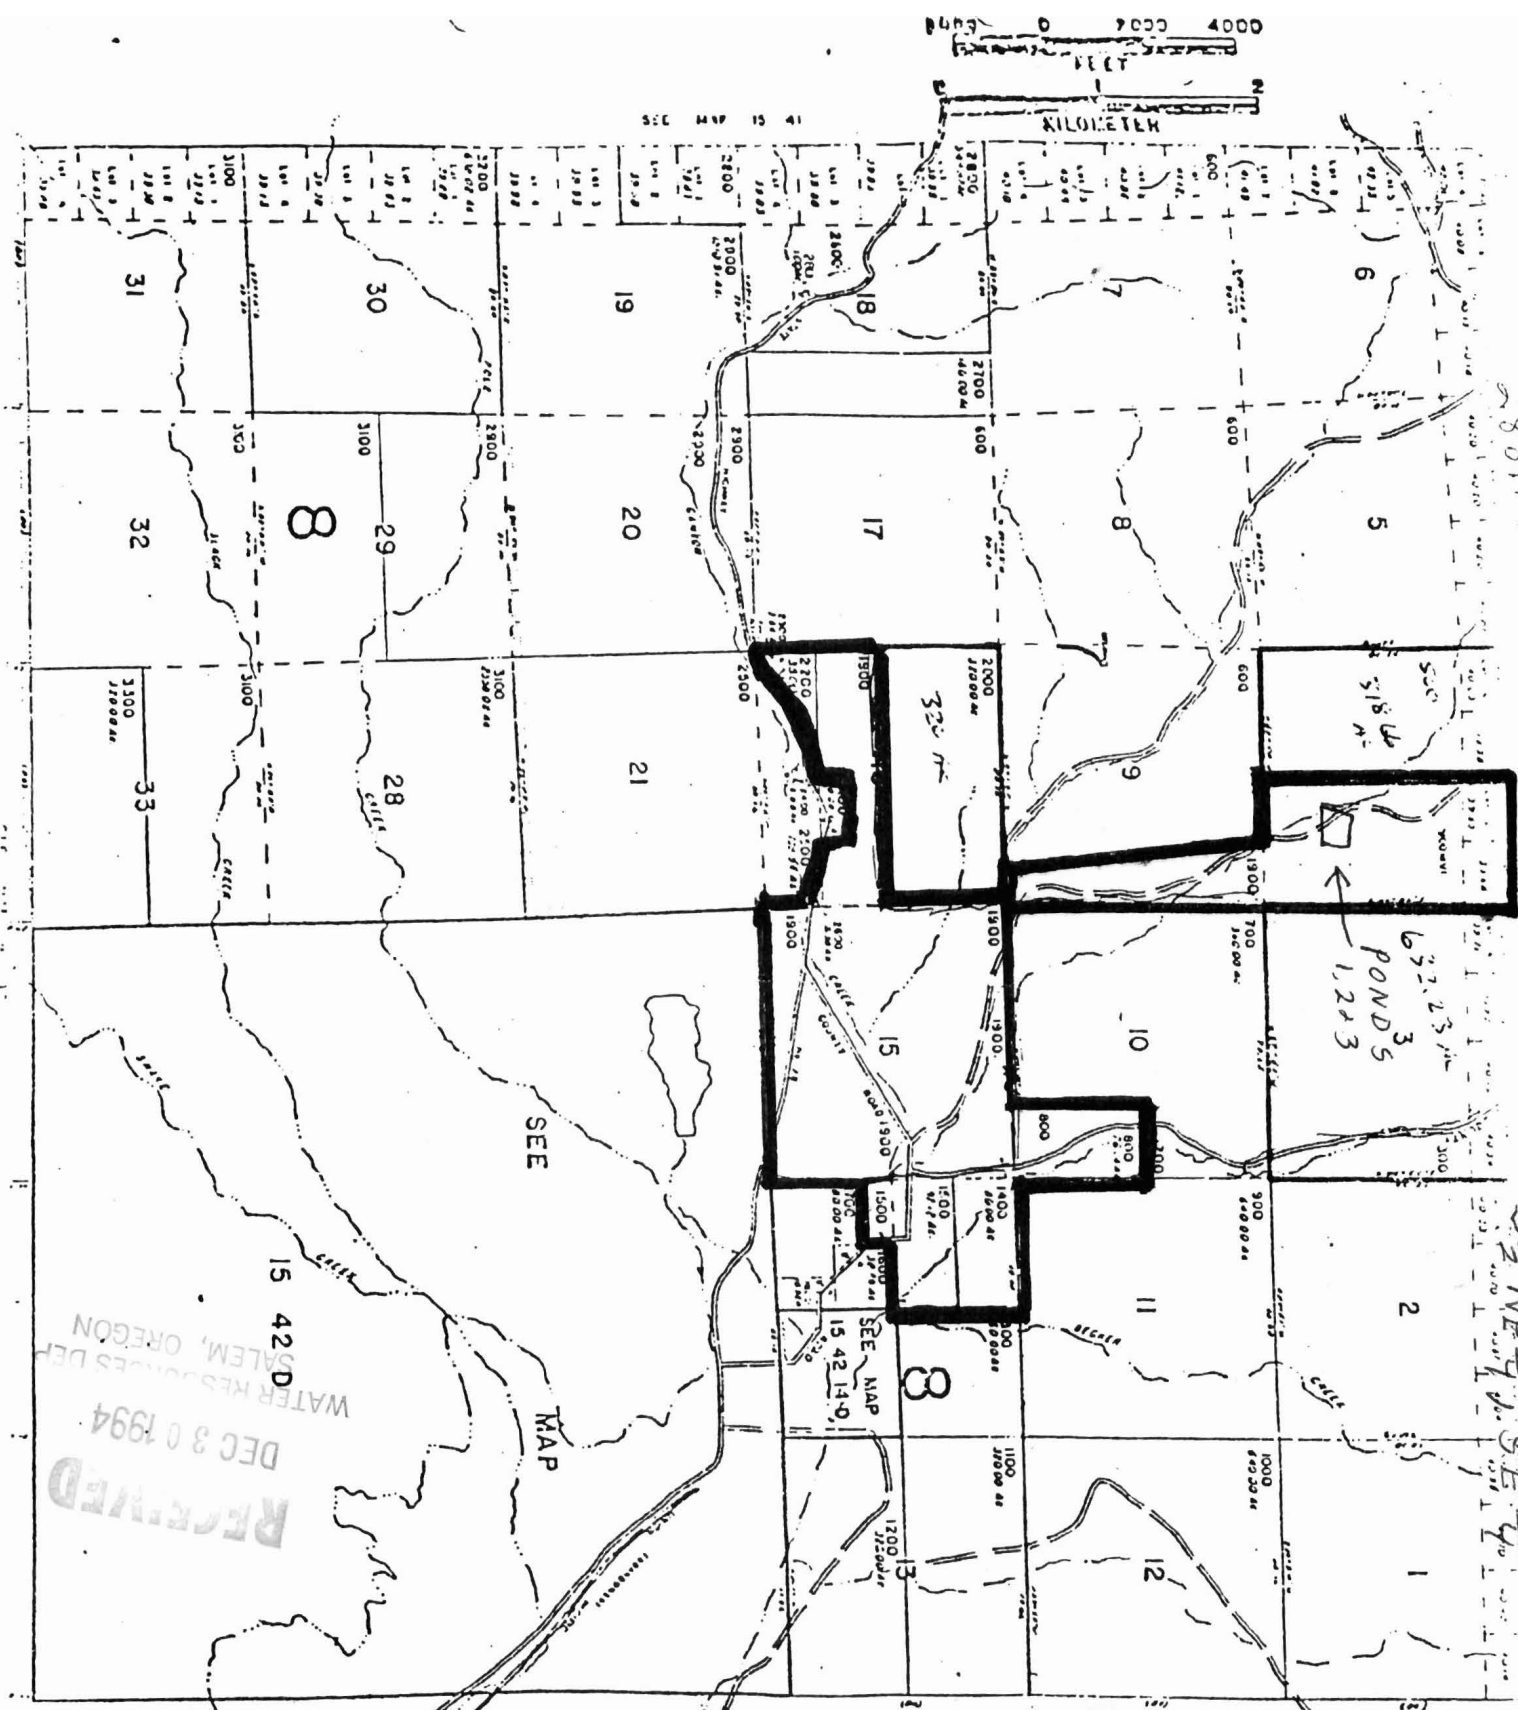

2881.48 TWP 15S, R 42E - SEC 15
 9 1/2 NE 1/4 of SEC 15

RECEIVED
 DEC 30 1994
 WATER RESOURCES DEPT
 SALEM, OREGON

RECEIVED
 DEC 21 1994
 WATER RESOURCES DEPT
 SALEM, OREGON

Compliments of
 LAND TITLE INSURANCE AGENCY
 This sketch is furnished
 to assist in property location
 and the company does not
 guarantee its accuracy.

15-42

Application No.
 Permit No.

R-80292