


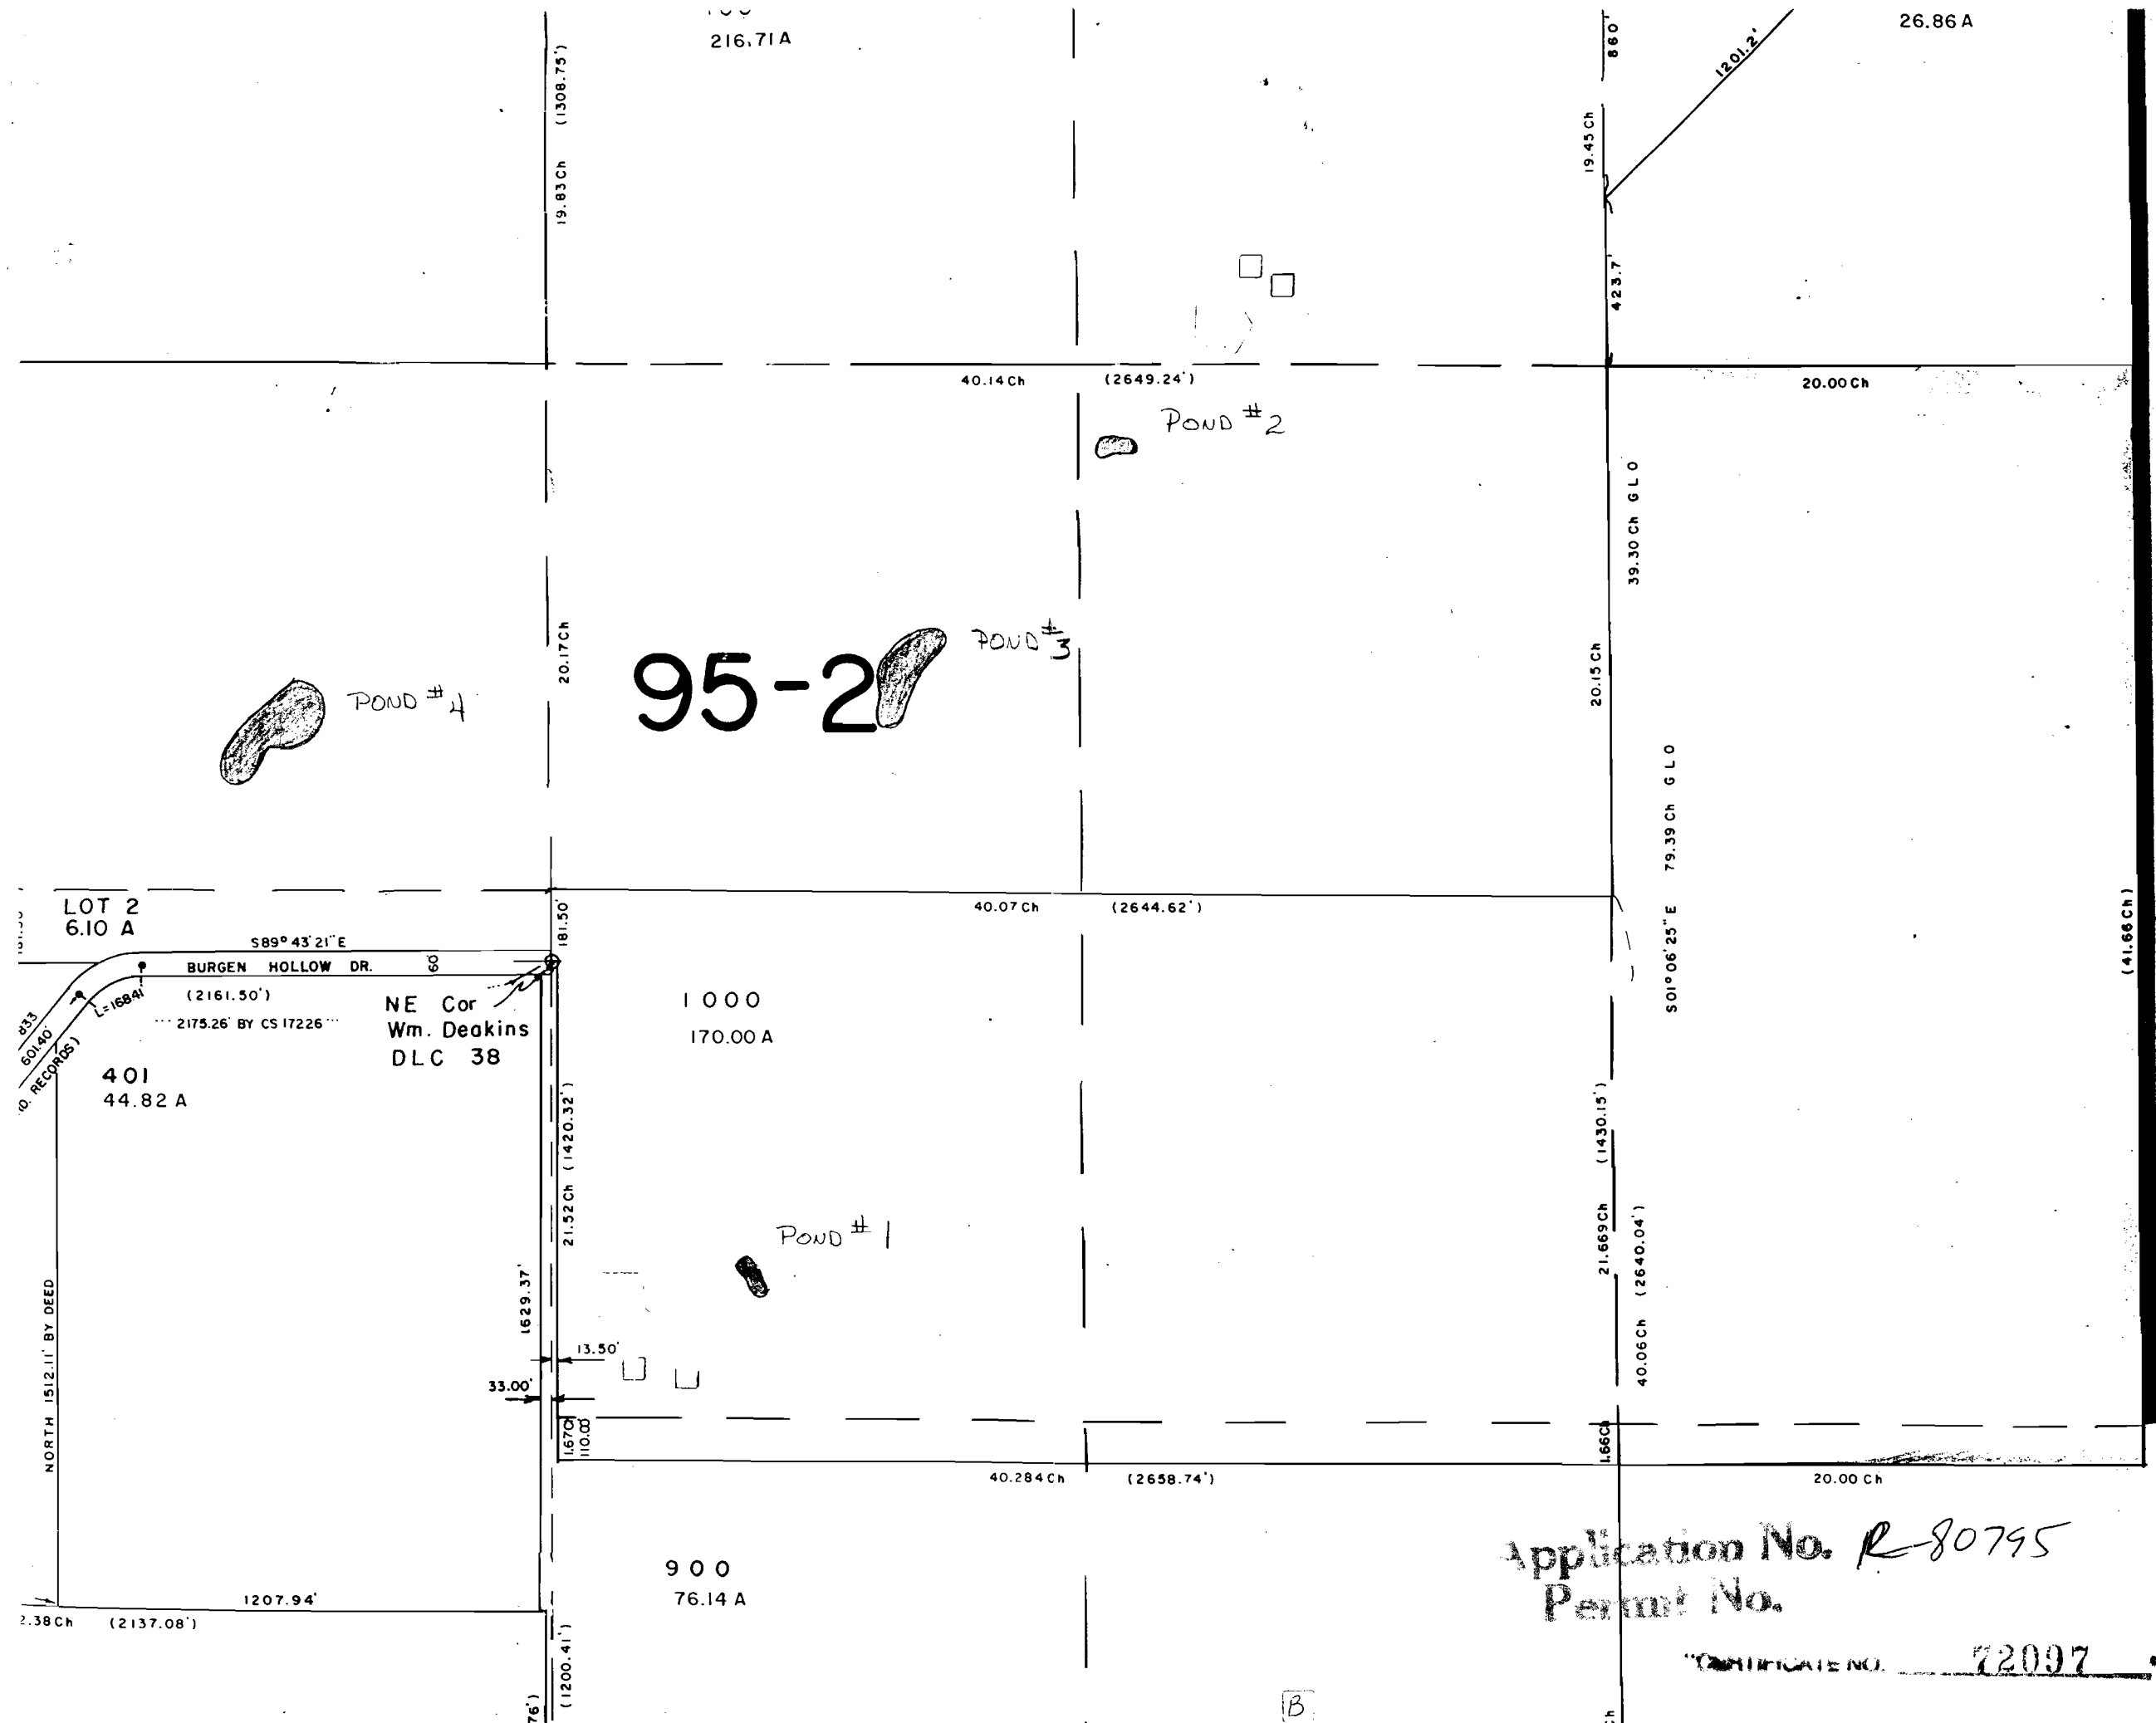


Index
IE
II
Map
See

Application No. R-80795
Permit No.

CERTIFICATE NO. 72097

B

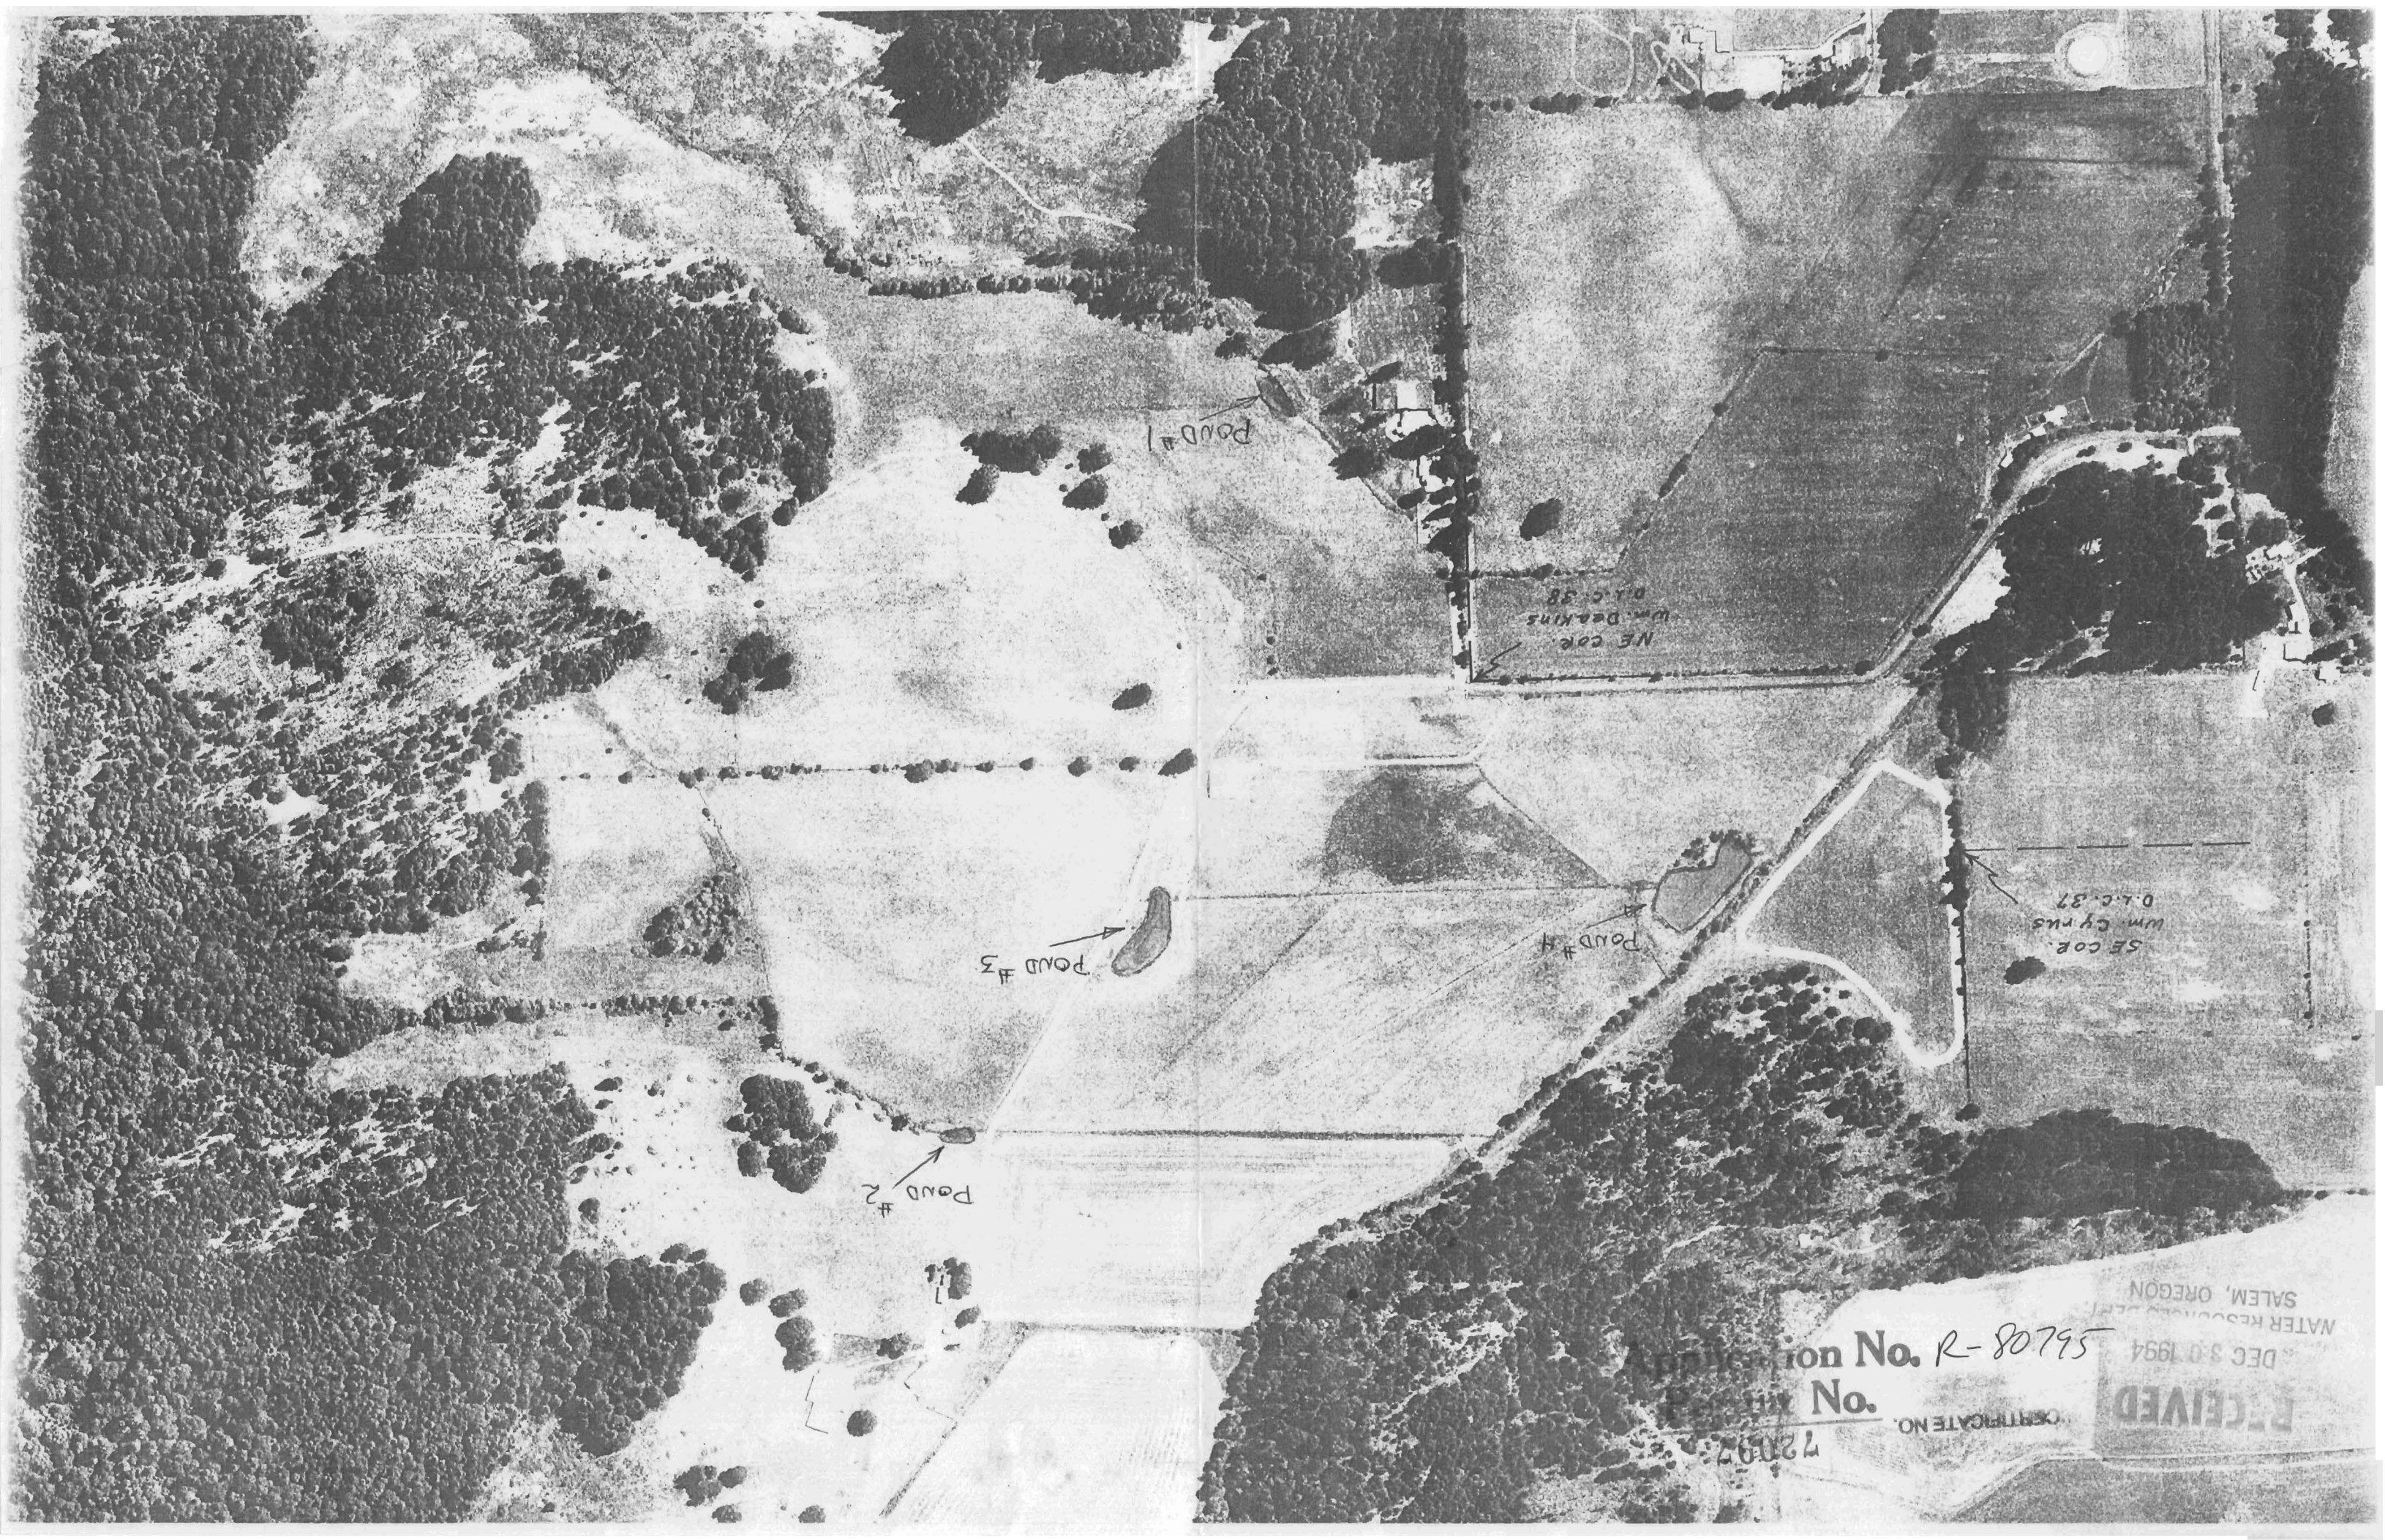

NE COR.
Wm. Deakins
D.C. 38

SE COR.
Wm. Cyrus
D.C. 37

POND #3

POND #4

POND #2

Application No. R-80795
Certificate No. 72092

RECEIVED
DEC 30 1994
WATER RESOURCES DEPT.
SALEM, OREGON