


Cadle Butte Quad T155 R18E

R-80901

950000
FEET

1/16/12 tile 9/30/02 SUP

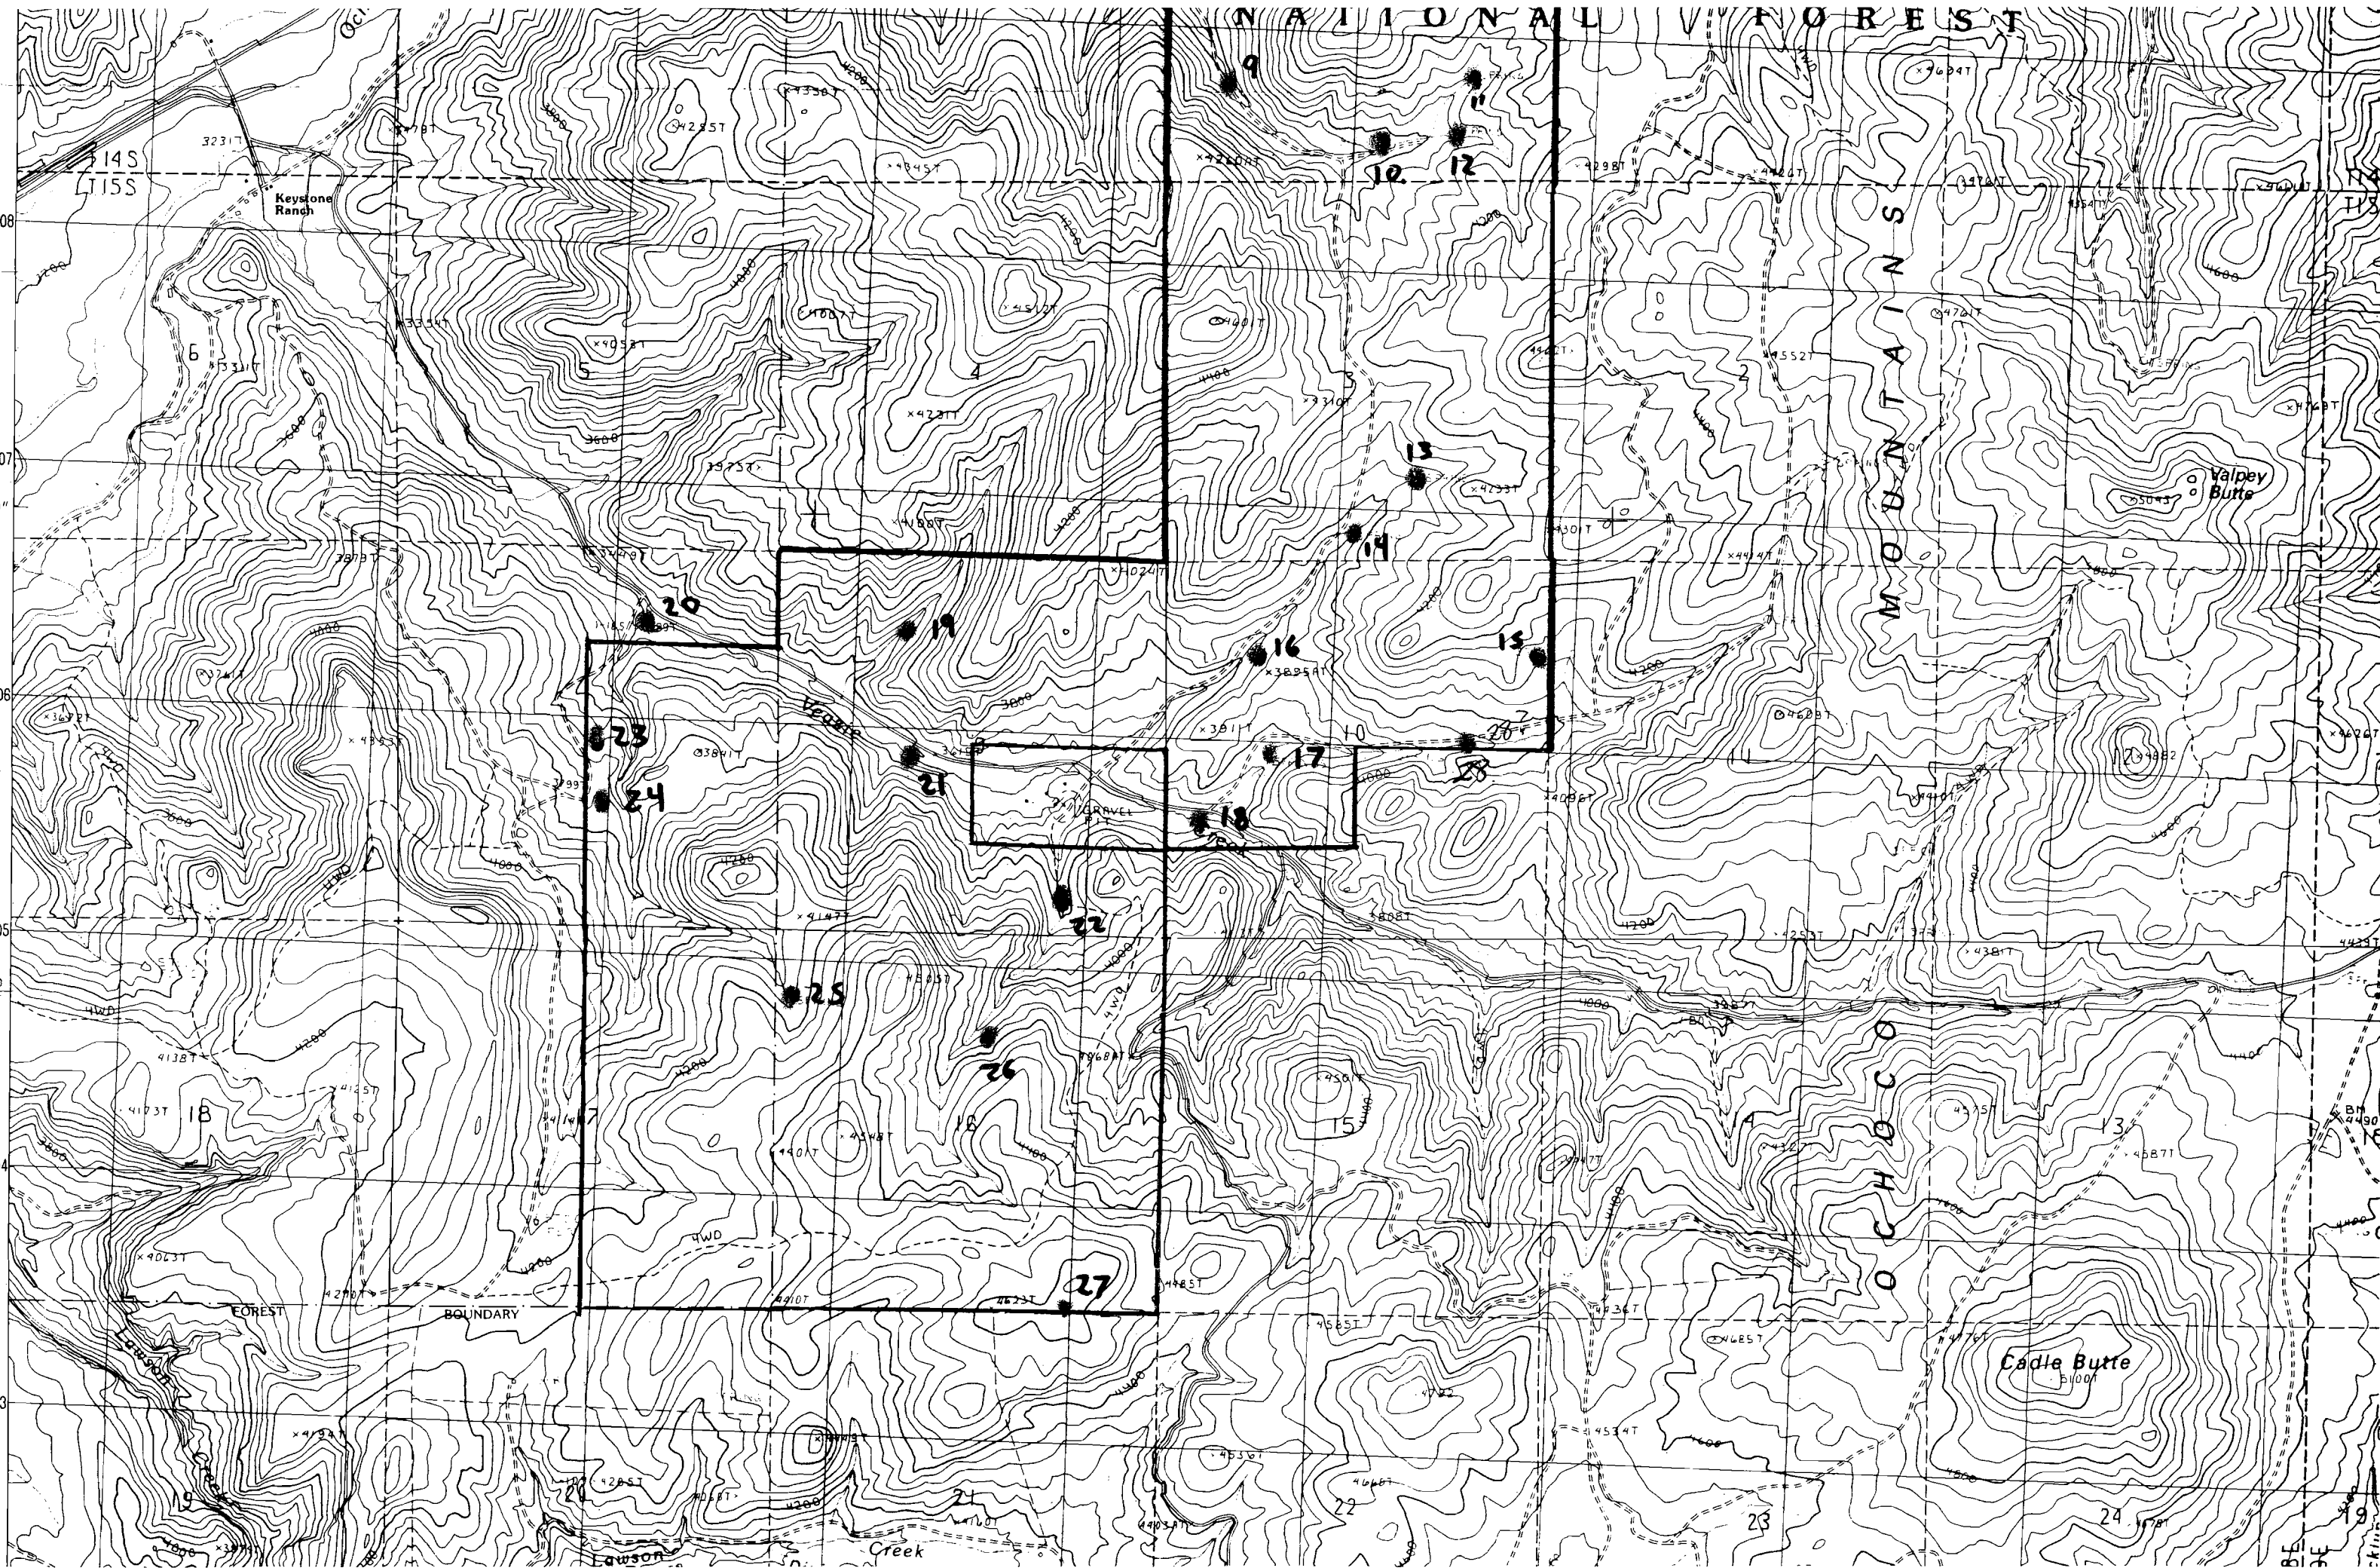

DERR MEADOWS QUADRANGLE
OREGON
7.5 MINUTE SERIES (TOPOGRAPHIC)

2073 III
(RICHMOND 1:62 500)

