


Township 6 South, Ranges 1 West & 1 East, W.M.

Portions of Sections 1 & 12 in Range 1 West
& Sections 6 & 7 In Range 1 East

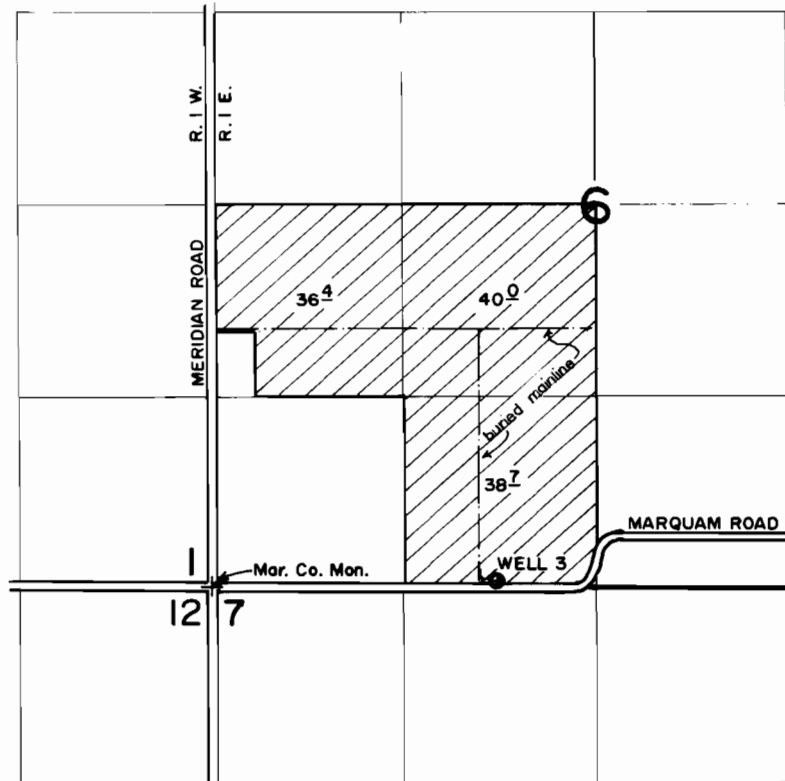

WELL 3 LOCATED 40' N. & 195.5' E. FROM THE SW COR. SEC. 6.

Appl. No. G-12296
Per. No. G-11322

FINAL PROOF SURVEY
in name of
GOSCHIE FARMS, INC.
September 10, 1991



THIS MAP WAS PREPARED FOR THE PURPOSE OF IDENTIFYING THE LOCATION OF A WATER RIGHT ONLY AND IS NOT INTENDED TO PROVIDE LEGAL DIMENSIONS OR LOCATION OF PROPERTY OWNERSHIP LINES.