

UNITED STATES  
DEPARTMENT OF THE INTERIOR  
BUREAU OF LAND MANAGEMENT

R-7395

72135

Kandra Waterhole #

01-15-19

SECTION


9


NE 1/4 NW 1/4

TOWNSHIP 40S, RANGE 11E, W. M.

North

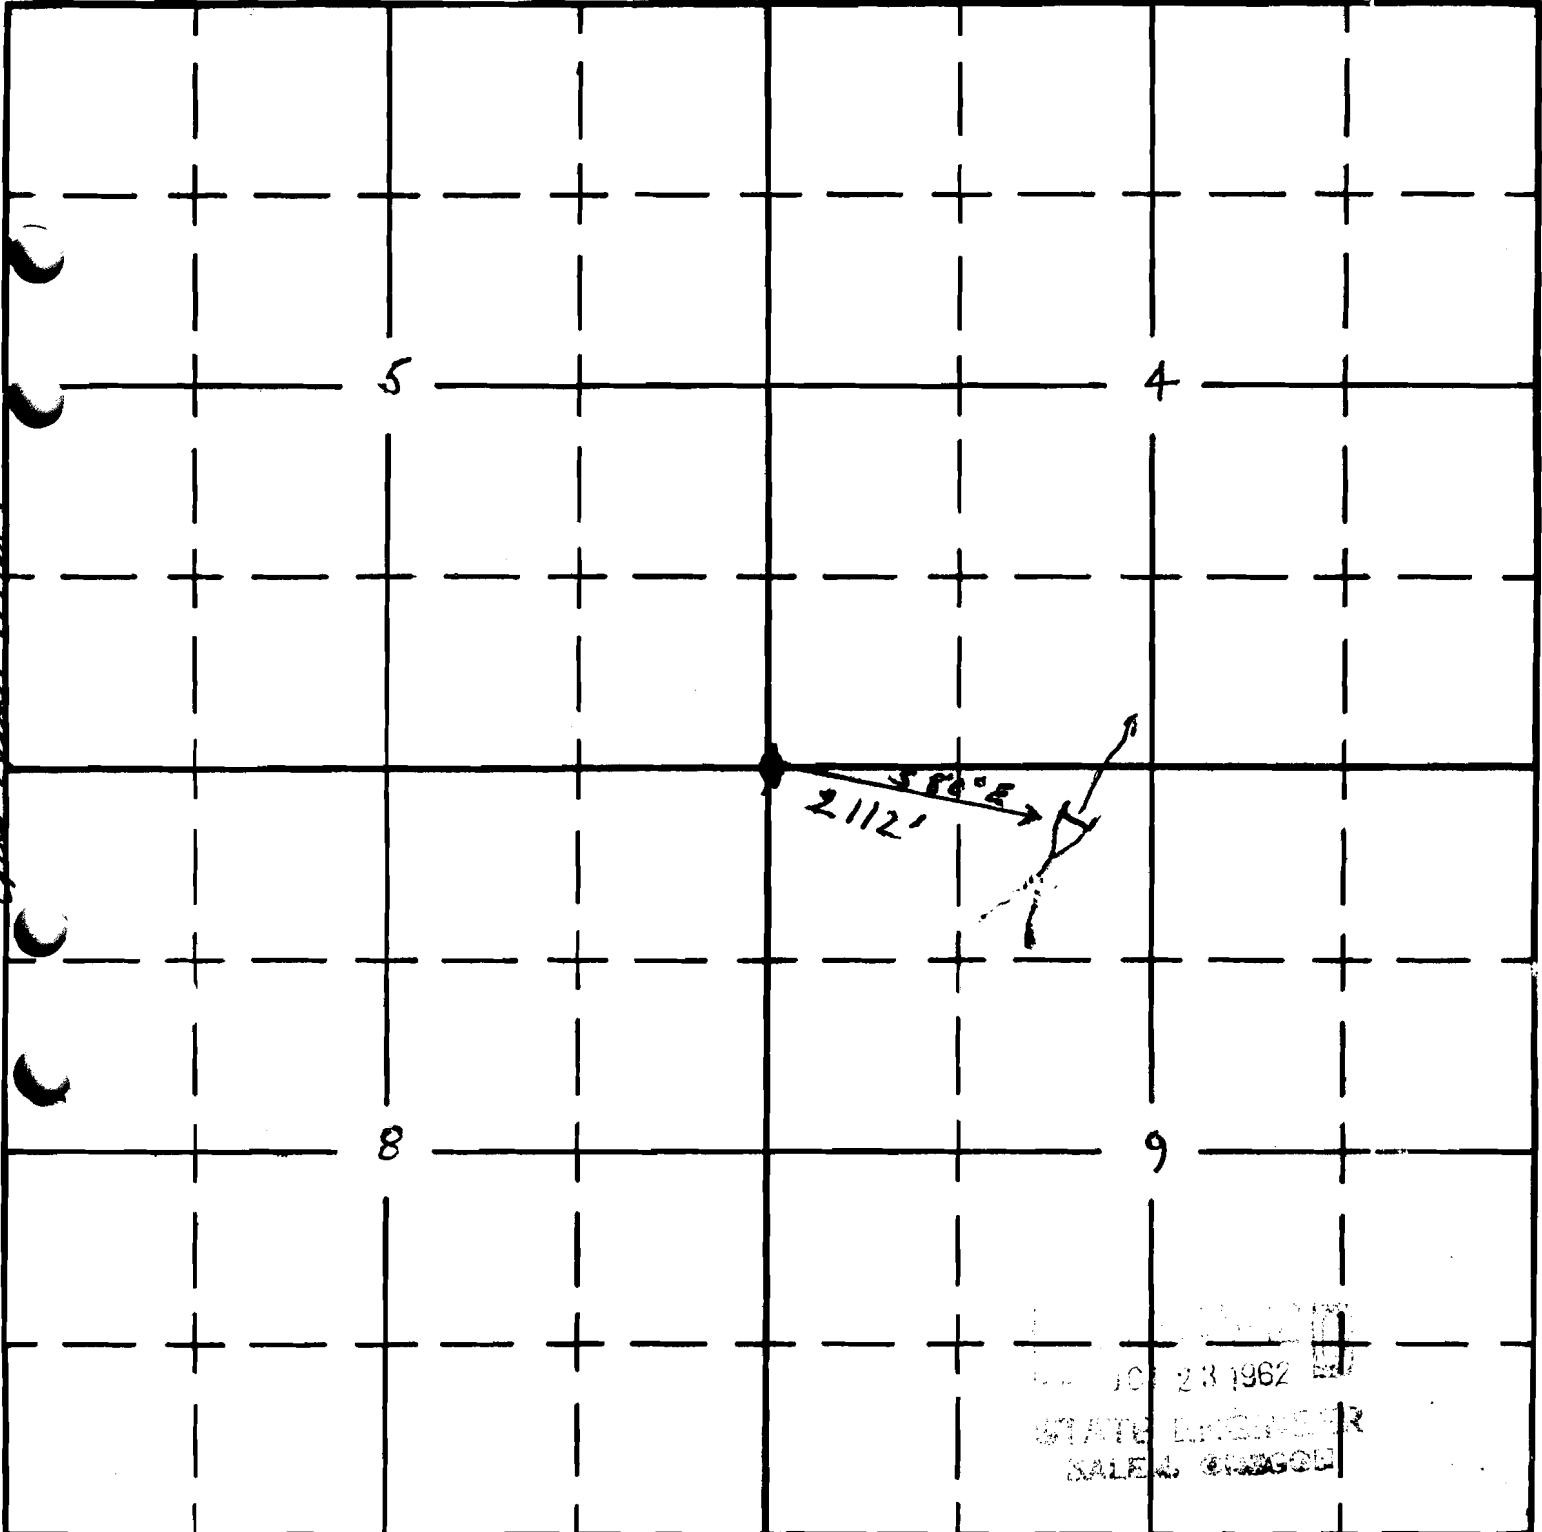

South

RECORDED  

D.E.  
11/13/62

APPLICATION No. R-38189  
PERMIT No. R 7395