

UNITED STATES
DEPARTMENT OF THE INTERIOR
BUREAU OF LAND MANAGEMENT

R-7784
72136

SECTION

Oregon State Water Filings


RECEIVED

AUG 22 1978

WATER RESOURCES DEPT.
SALEM, OREGON

24
NE 1/4 SE 1/4 TOWNSHIP 40 S, RANGE 14 1/2 E, W. M.

North

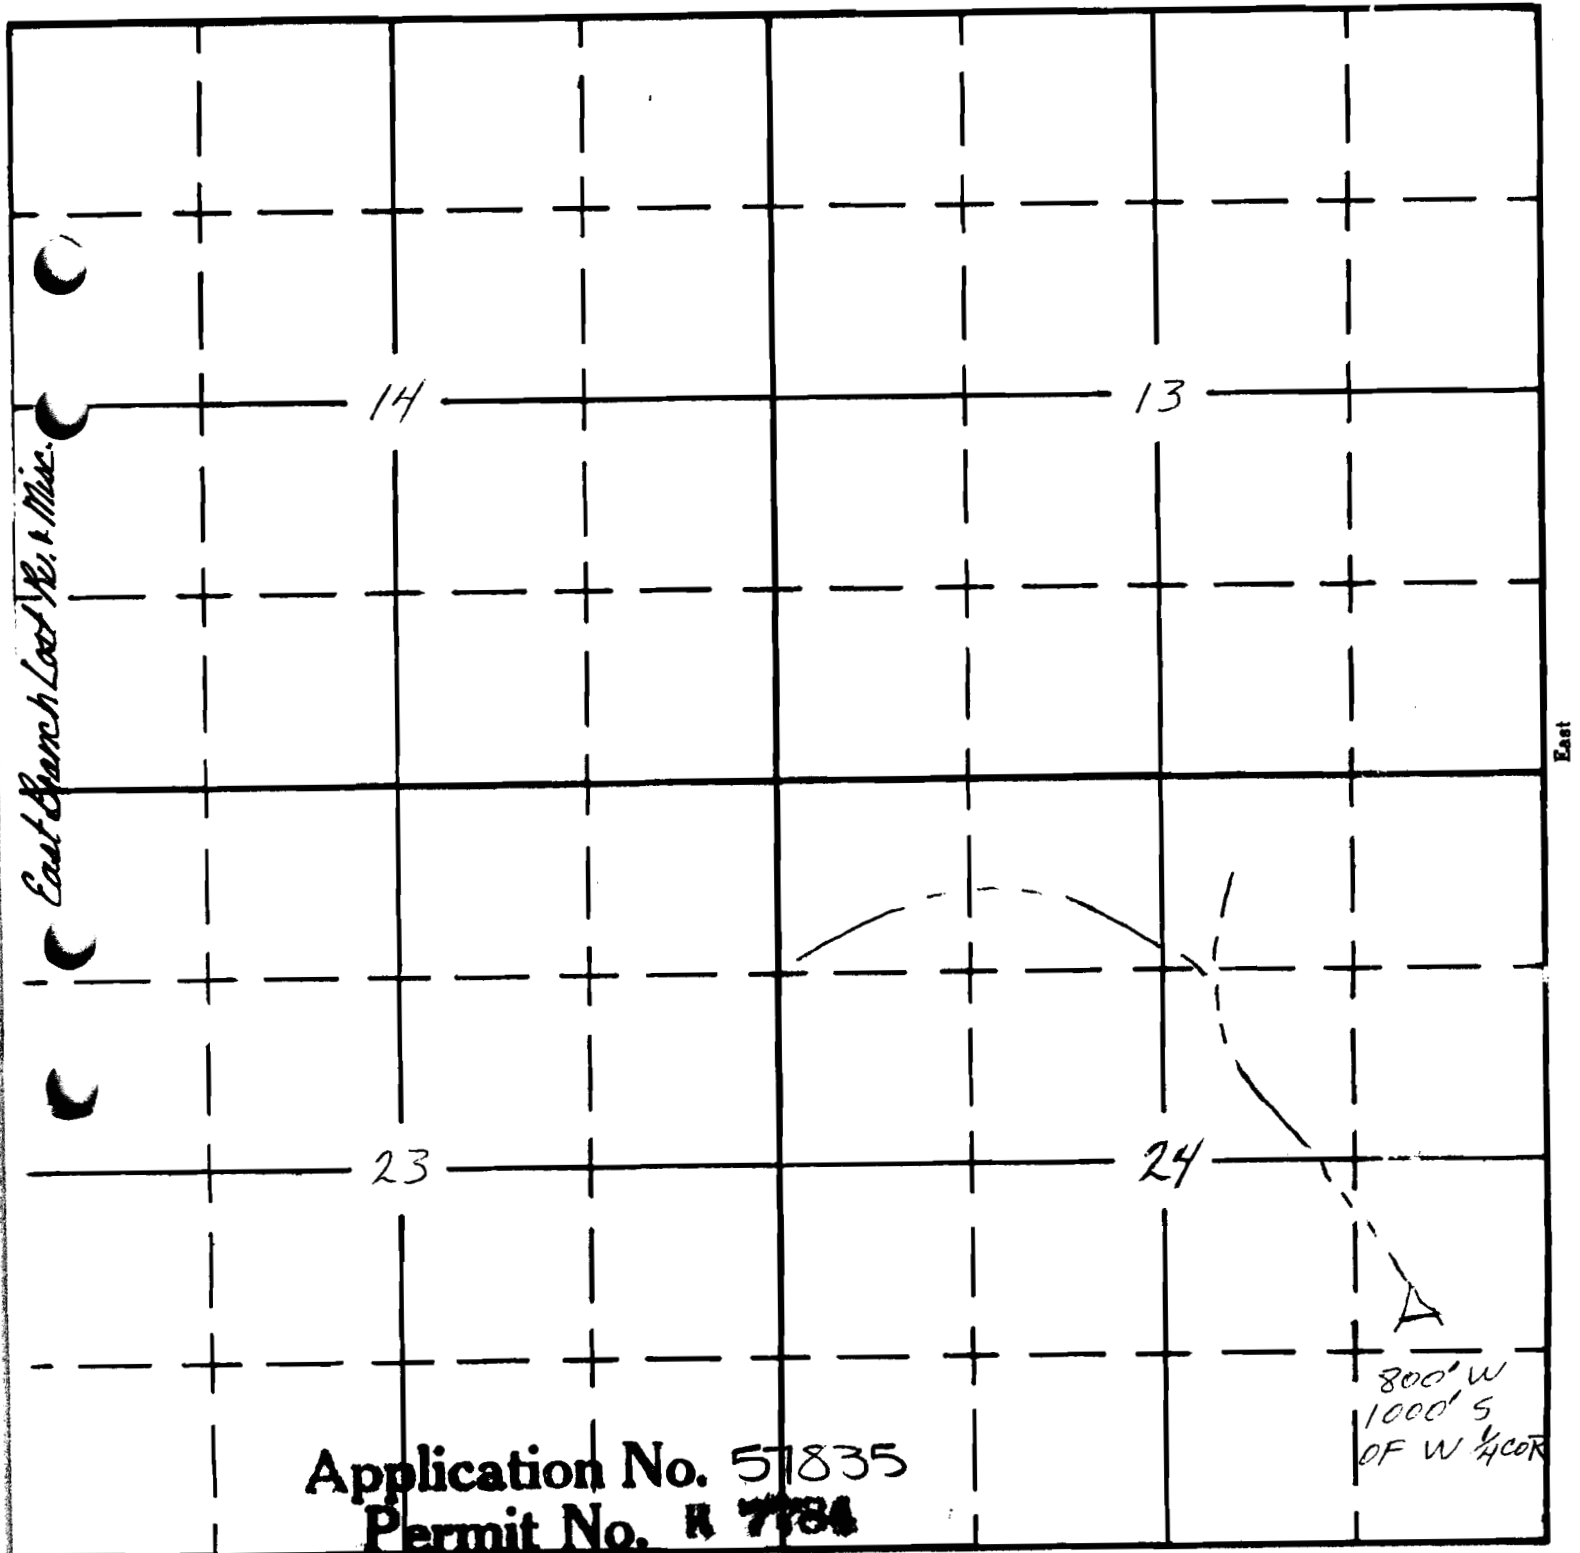

Application No. 51835
Permit No. R 7784

South

APPLICATION No.

PERMIT No.