

RECEIVED

T.23S., R.8W., W.M.

OCT 01 1991

WATER RESOURCES DEP  
SALEM, OREGON


RECEIVED

JUL 10 1992

WATER RESOURCES DEPT.  
SALEM, OREGON

1" = 1320'

Area Irrigated

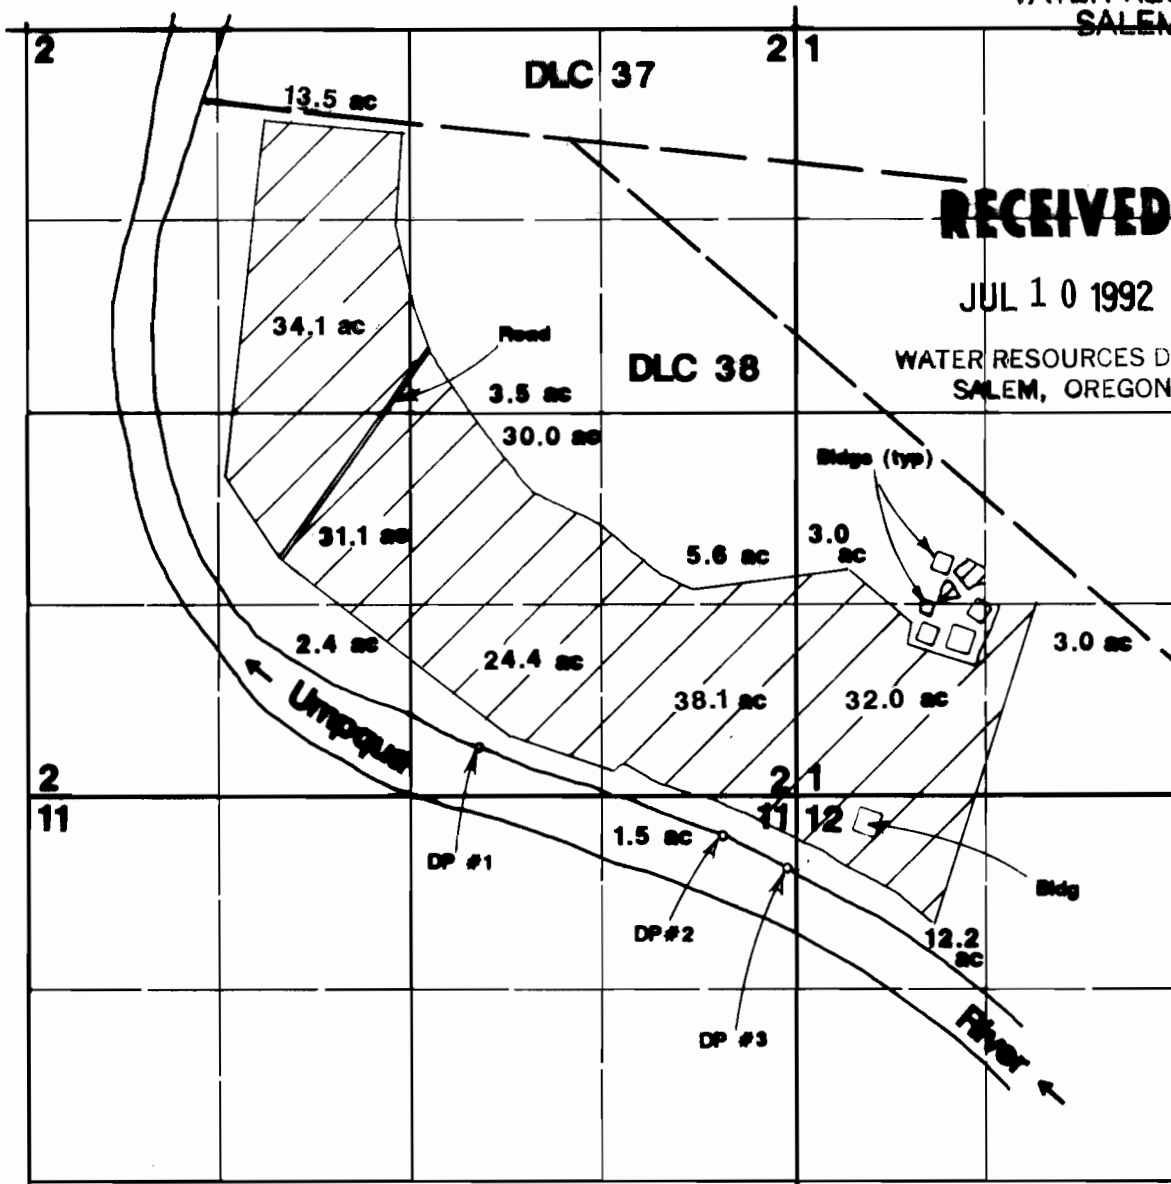


Div Pt #1 located 324.45'N & 2164.25'W to corner common to Sections 1, 2, 11 & 12.  
 Div Pt #2 located 251.99'S & 476.49'W from corner common to Sections 1, 2, 11 & 12.  
 Div Pt #3 located 447.5'S & 37.5'W from corner common to Sections 1, 2, 11 & 12.

### Final Proof Survey

Application #: 69398      Permit #: 50154

State of Oregon  
Dept of Forestry

Surveyed on September 11, 1991 by JM Schuette

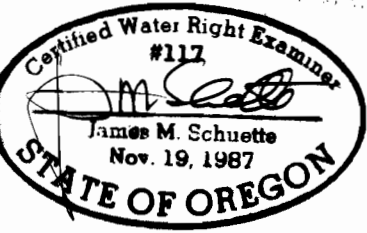

THIS MAP WAS PREPARED FOR THE PURPOSE OF  
 IDENTIFYING THE LOCATION OF A WATER RIGHT  
 ONLY AND IS NOT INTENDED TO PROVIDE LEGAL  
 DIMENSIONS OR LOCATION OF PROPERTY  
 OWNERSHIP LINES.