


T.35S.R.1W.W.M.

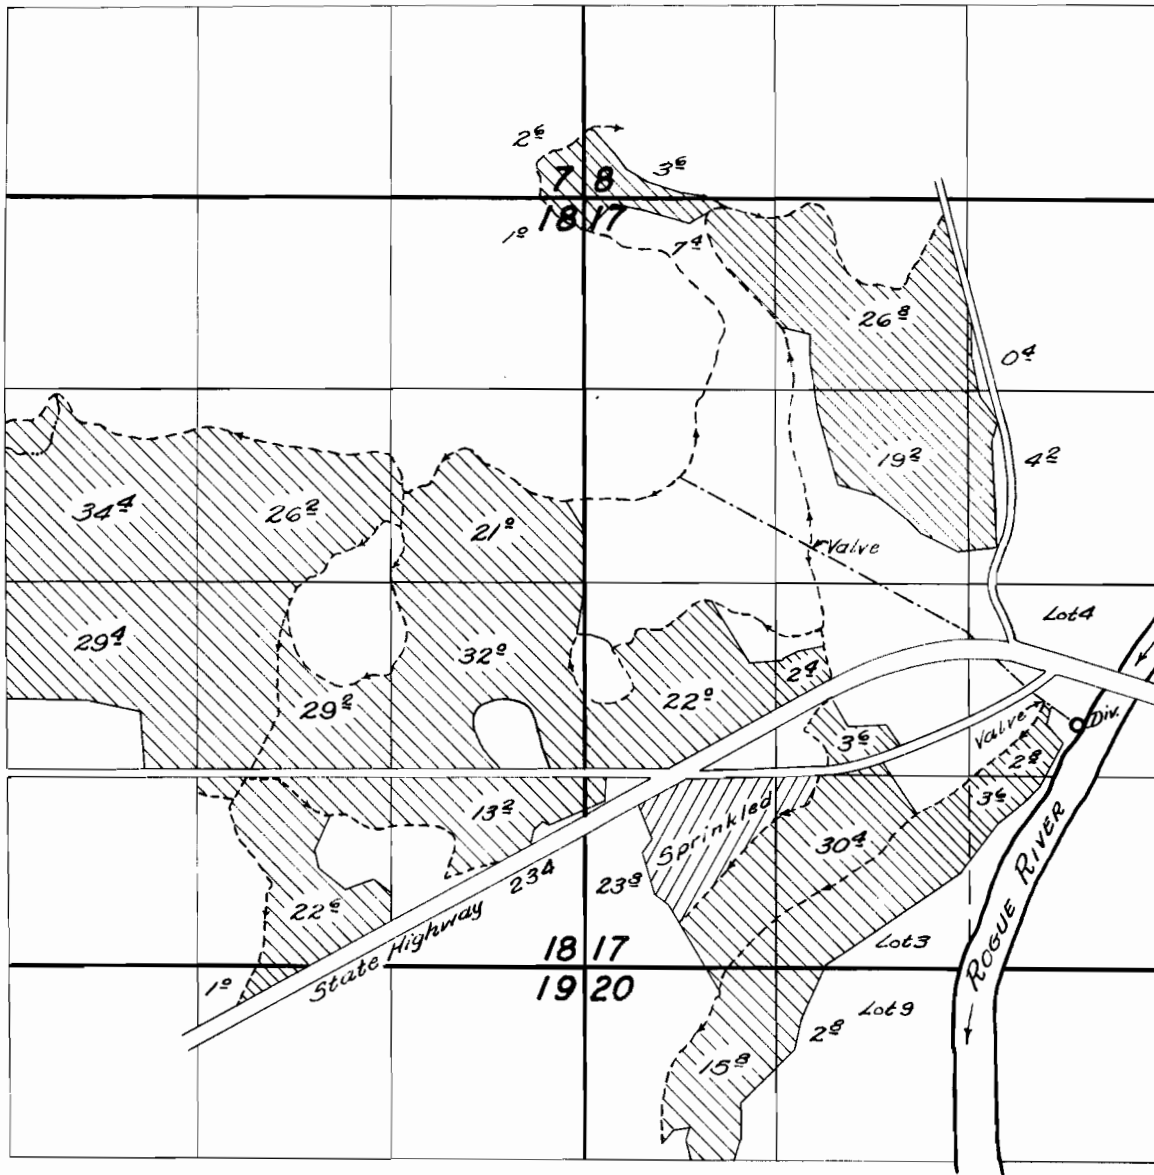

FINAL PROOF SURVEY  
UNDER

APPL. NO. 197 PERMIT NO. 298  
IN NAME OF

B. L. DODGE

SURVEYED MAY 8, 12, 13, 1959 BY C. O. Baetels