

AS 12 E



5876

9 10 11 12


STATE ENGINEER
SALEM OREGON
MAY 18 1923

16 15 14 13

21 22 23 24

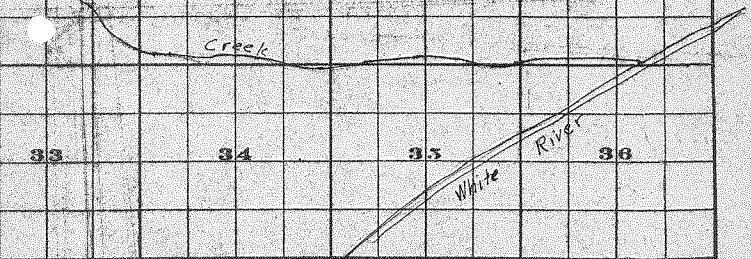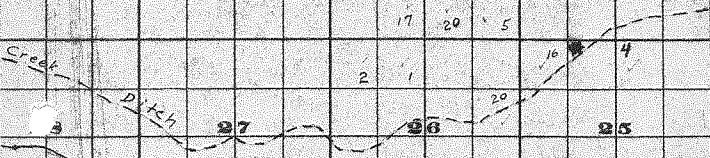

33 34 35 36

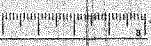

Application No. 5876
Permit No. 5876

FROM OFFICE OF THE STATE ENGINEER, SALEM, OREGON