


50803

68747

72154

1" = 200'

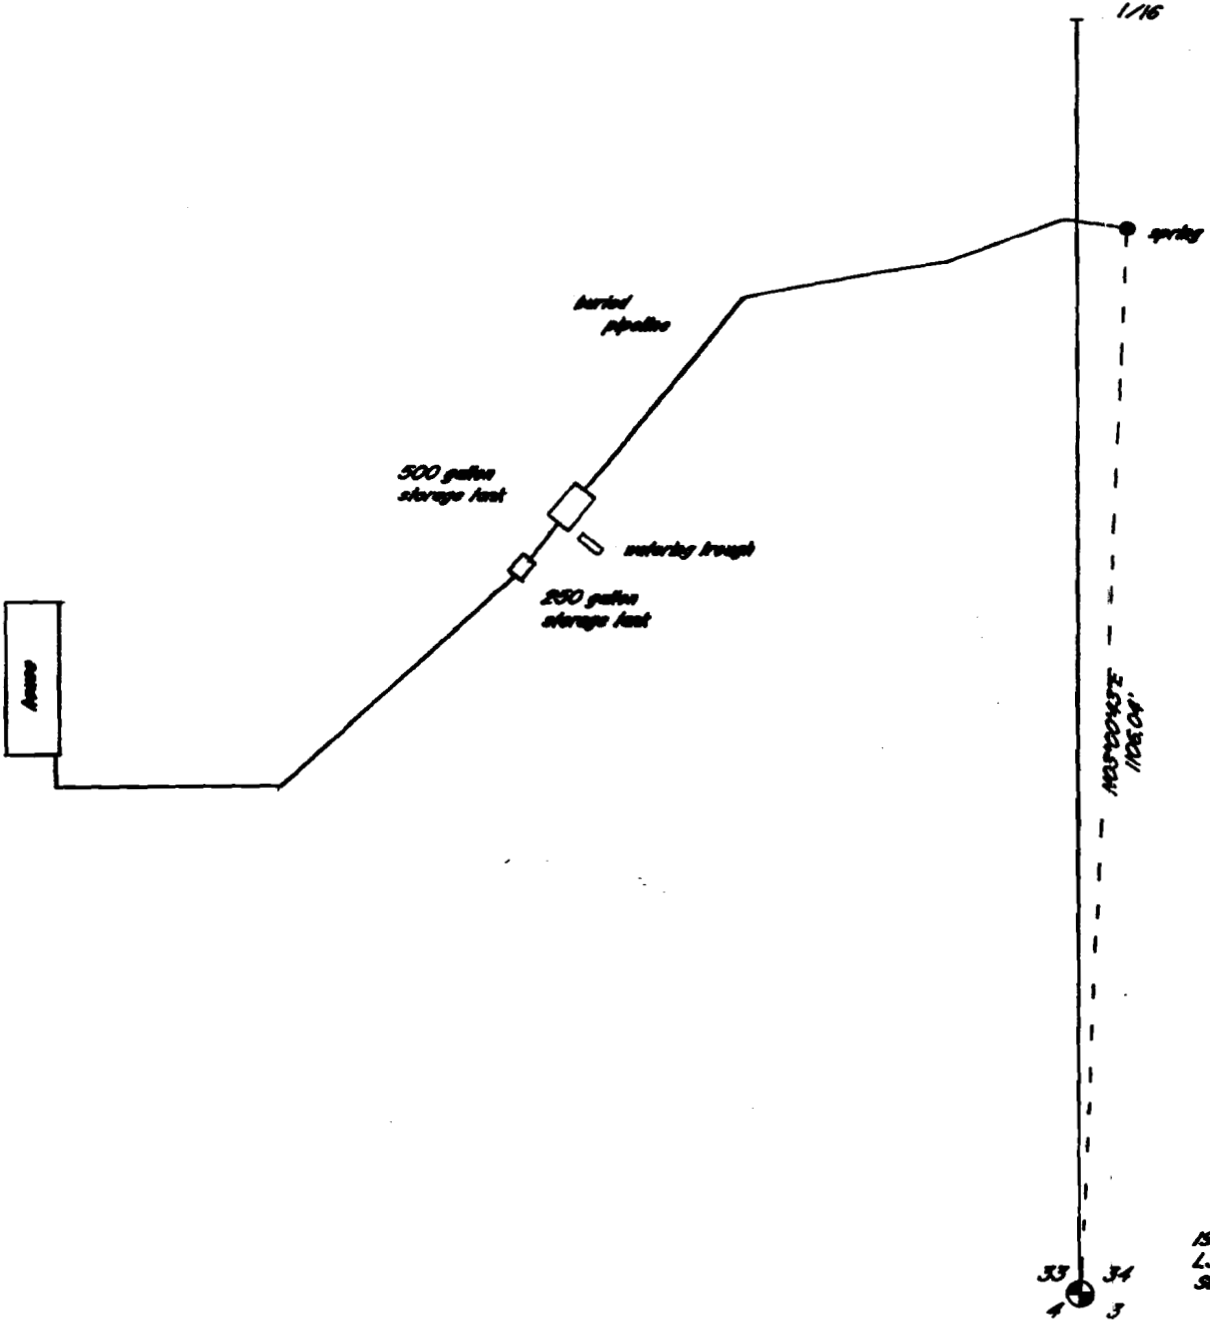

1968 Area cap  
LS # 744 Record  
Survey # 1045

**FINAL PROOF MAP**  
 SE 1/4 SE 1/4 Section 33, T.38S, R.20E, W.M.  
 Lake County, Oregon

Robert C. and Gloria B. Utley

Application # 69281  
Permit # 50803



*This map is for the purpose of identifying the location of the water right only and is not intended to provide legal dimensions or location of property ownership lines.*

Drawing # WR 3391  
12/12/91