
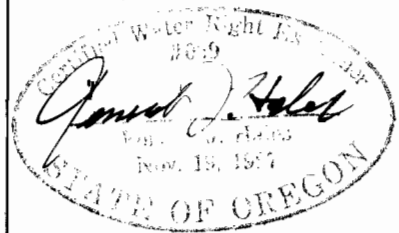


T. 27 S., R. 12 W. W.M.
FINAL PROOF SURVEY

SCALE 1" = 200ft.

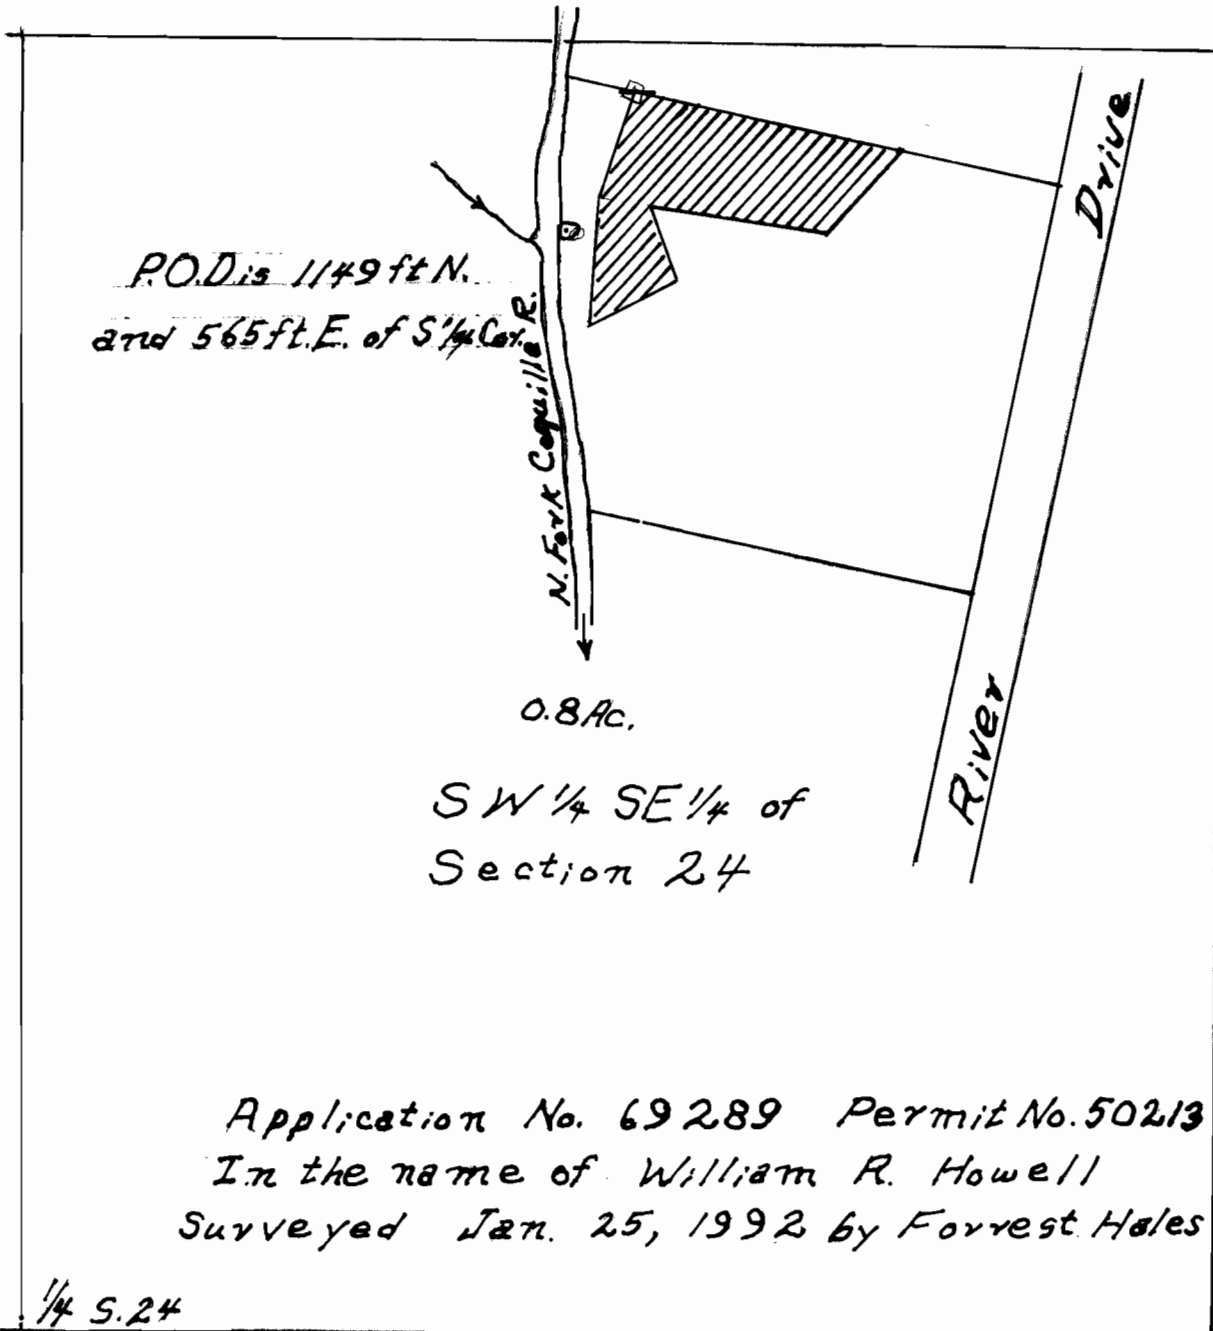

¹/₄ S. 24
S 25