



33

33

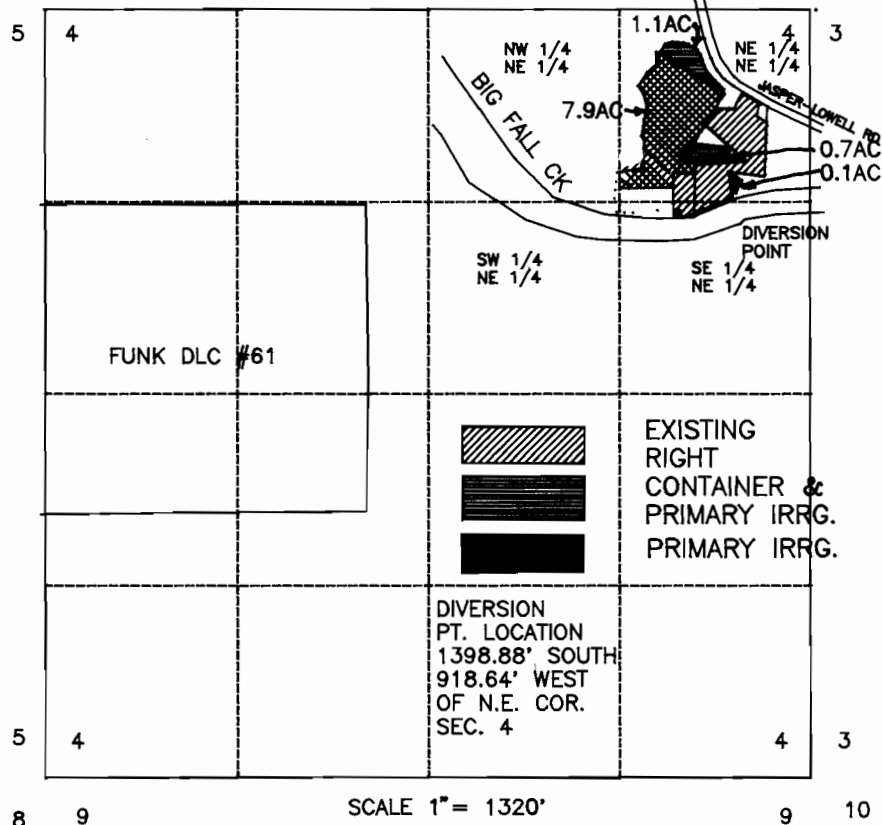

NOTE:
THE PREPARATION OF THIS MAP
WAS FOR THE PURPOSE OF IDENTIFYING
THE LOCATION OF THE WATER RIGHT
ONLY. IT IS NOT INTENDED TO
PROVIDE LOCATION NOR DIMENSIONS
OF OWNERSHIP LINES.

FINAL PROOF SURVEY
FOR
DAVID & BARBARA BRAZELTON
39318 JASPER-LOWELL RD
LOWELL, OR 97452
SEC. 4, T19S, R1W, W.M.
BY
STEPHEN H. FORD INC.
1120 BAILEY HILL RD #5
EUGENE, OR 97402
(503) 344-1852
PERMIT NO. 50735
APPLICATION NO. 69918
JOB NO. 2647

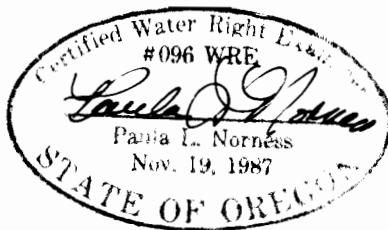

REVISED 8-1-91