
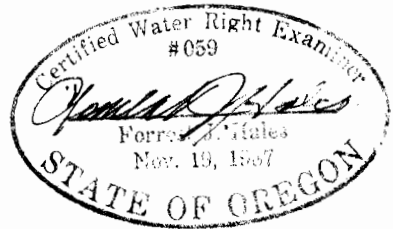


T. 27 S., R. 11 W. W.M.  
SECTION 7

Scale 1" = 400ft.

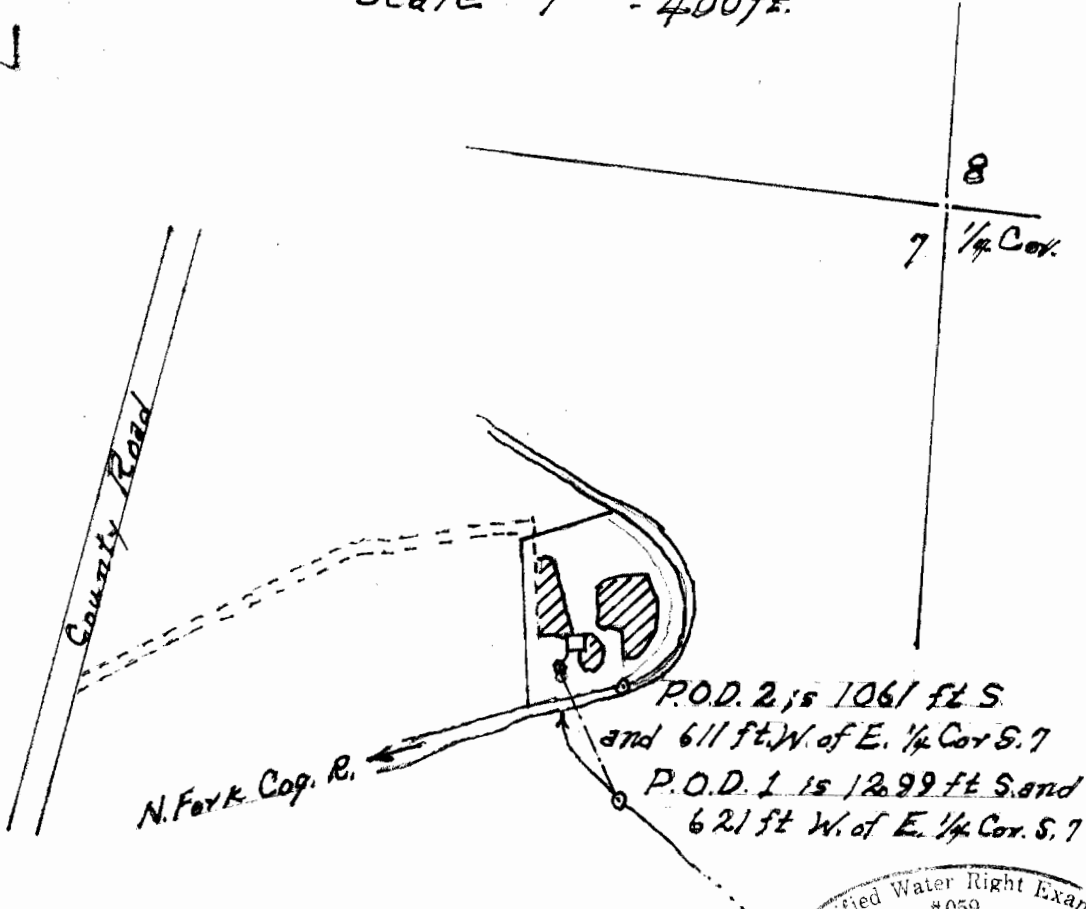

FINAL PROOF SURVEY  
UNDER

Application No. 70328 Permit No. 51058

IN NAME OF

D. M. and LOUISE JENNINGS JONES

Surveyed October 25, 1990.