


T.39S., R.1E., WM

SW 1/4 Sec 4

This map was prepared for the purpose of identifying water right locations only and is not intended to show property ownership lines or dimensions.

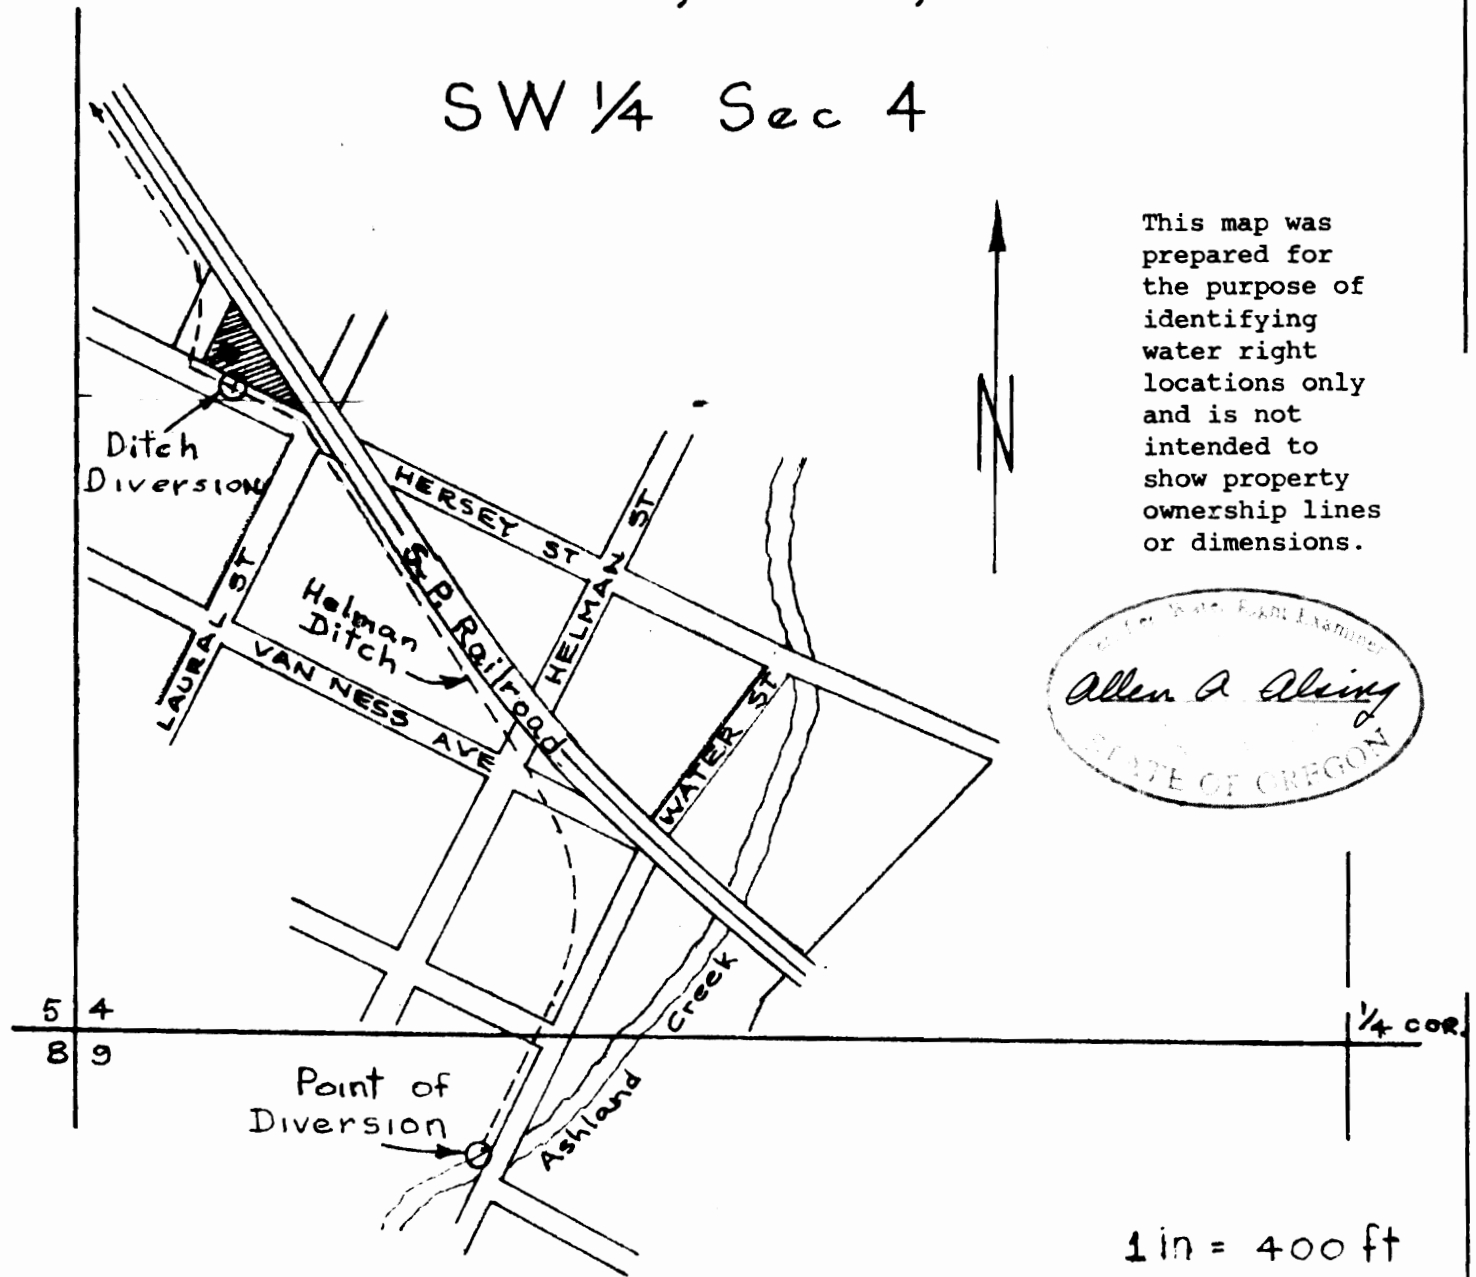

FINAL PROOF SURVEY
UNDER

Application No T-6146 R.R. Decree 16026
IN NAME OF

A. I. GROSS

Surveyed Sept 30, 1991 By *Allen A. Alving*