

FINAL PROOF SURVEY


LOCATED IN TOWNSHIP 35 SOUTH, RANGE 1 WEST OF THE
WILLAMETTE MERIDIAN, IN THE NORTHEAST QUARTER OF SECTION 36

T33S

RECEIVED

DEC 05 1991

WATER RESOURCES DEPT
SALEM, OREGON

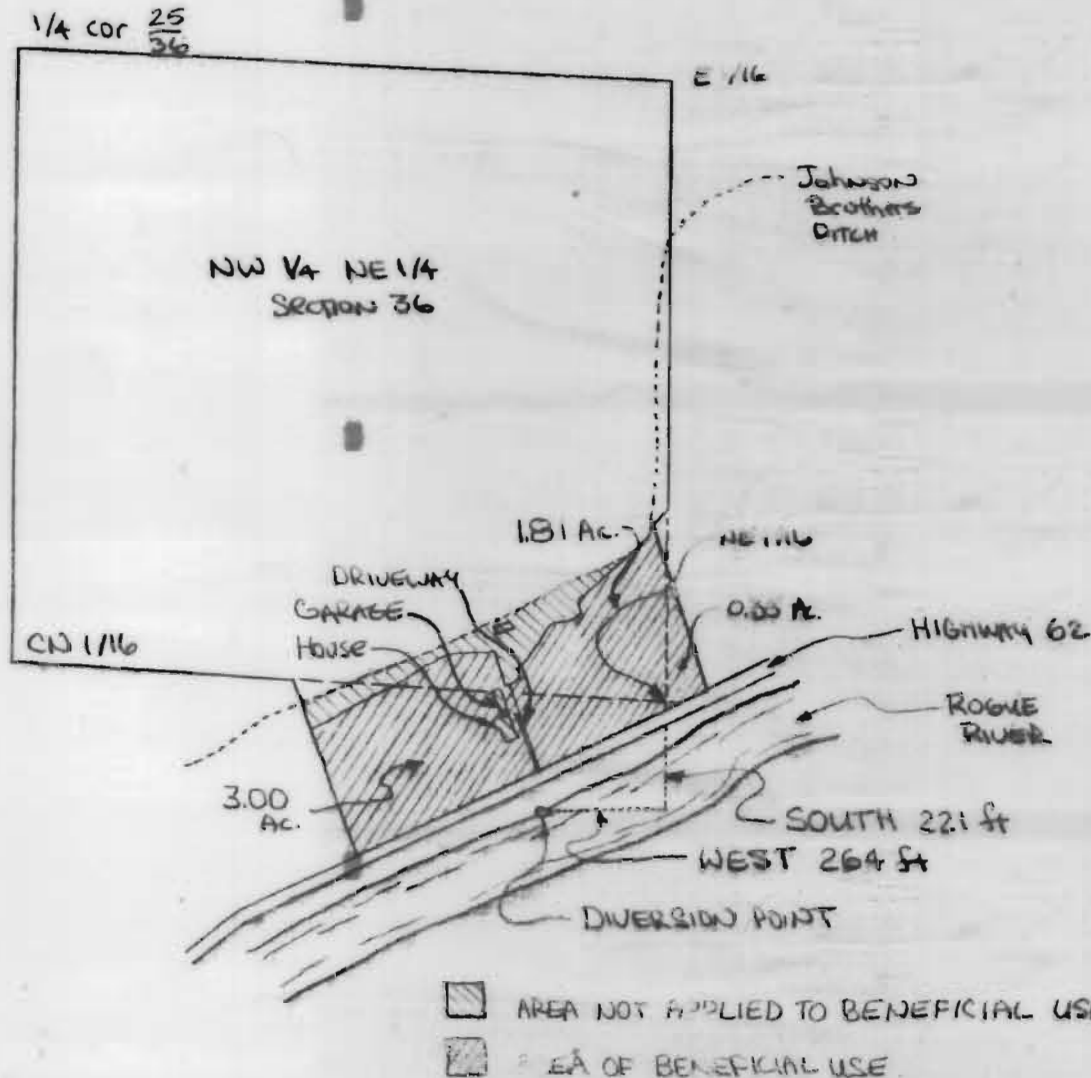


APPLICATION NO. T-6260
IN NAME OF

RUTH SAWYERS

SCALE 1"=400'

SURVEYED 11-9-91
- by

FARBER SURVEYING
PO BOX 5286
CENTRAL POINT OR 97502
(503) 776-0846

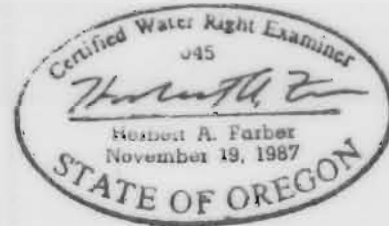

NOTE: THE PREPARATION OF THIS MAP WAS FOR
THE PURPOSE OF THE PROPOSED WATER RIGHT
AND HAS NO INTENT TO PROVIDE DIMENSIONS OR
LOCATIONS OF PROPERTY OWNERSHIP LINES