


G 10870


72181

**THIS MAP WAS PREPARED FOR THE PURPOSE OF IDENTIFYING THE LOCATION OF THE WATER RIGHT AND IS NOT INTENDED TO PROVIDE LEGAL DIMENSIONS OR LOCATIONS OF PROPERTY OWNERSHIP LINES.**

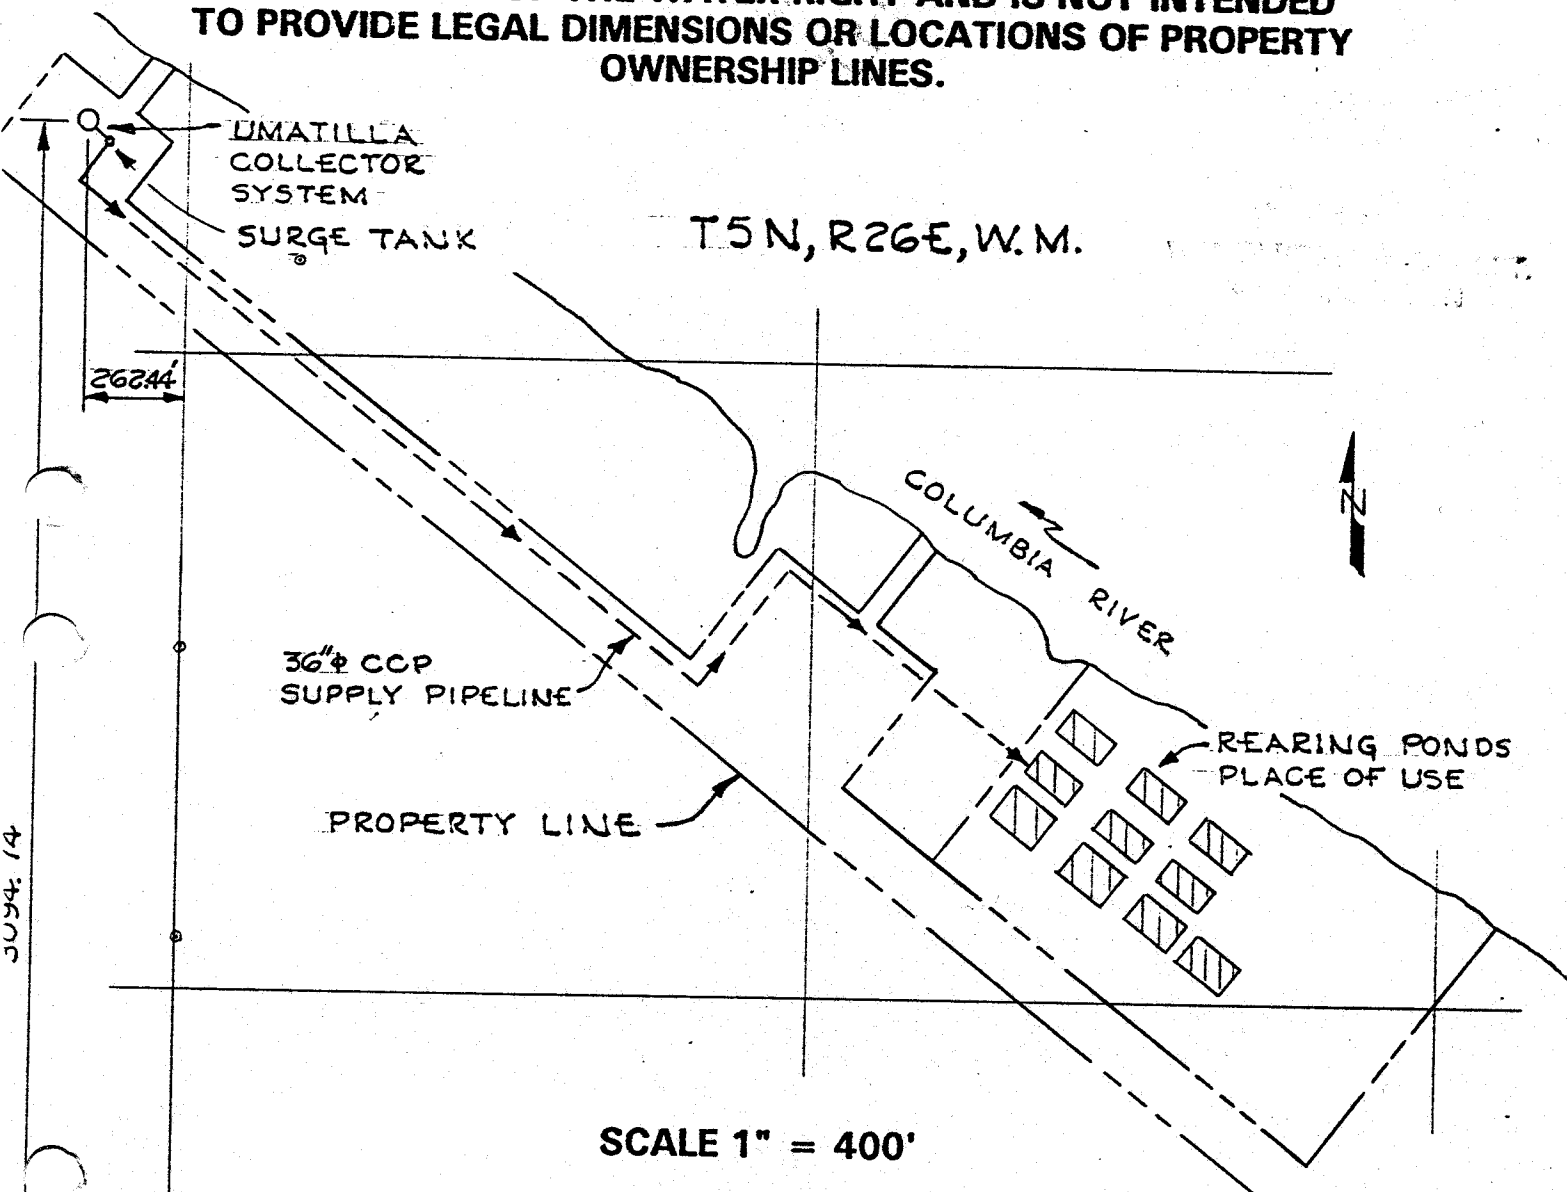

SCALE 1" = 400'

POD LOCATED 3094.74' NORTH AND 262.44' WEST OF THE SE CORNER OF SECTION 16

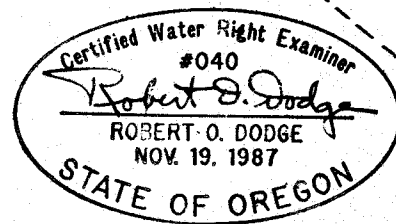

**FINAL PROOF SURVEY UNDER**

APPLICATION NO. 11834 PERMIT NO. 10870

IN NAME OF

BONNEVILLE POWER ADMINISTRATION

SURVEYED: 6/2/1992 BY: DODGE

16	15
21	22