
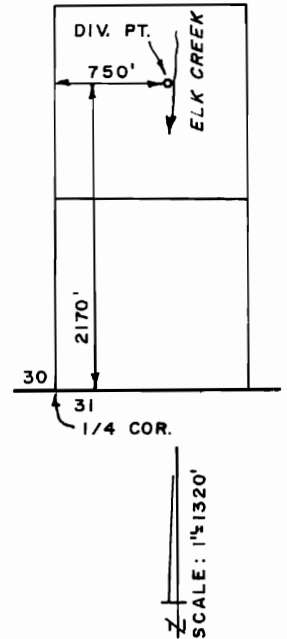


T.33S., R.1E., W.M.

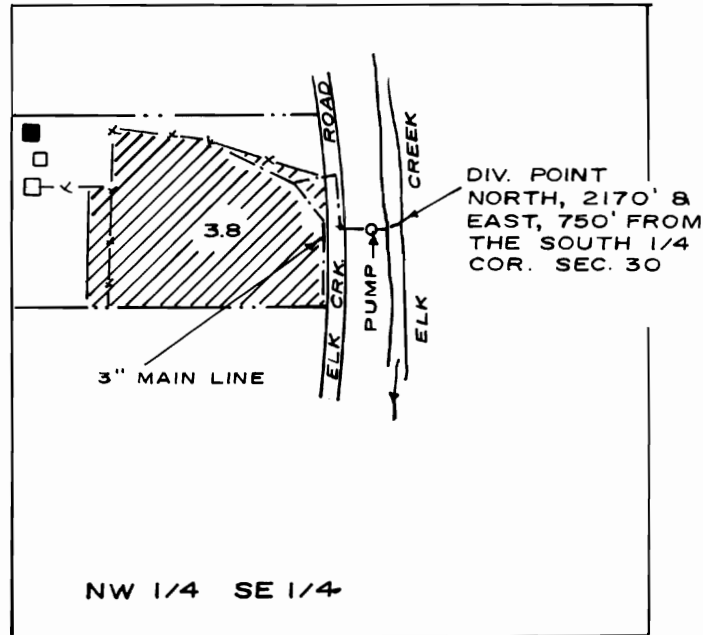

SCALE: 1" = 400'

FINAL PROOF MAP

APPLICATION No. T-6328

NOTE THIS MAP HAS BEEN PREPARED FOR WATER RIGHT PURPOSES ONLY, NOT FOR PROPERTY BOUNDARY LOCATIONS

IN THE NAME OF

DANIEL H. MEYER, SR.
& JACKIE M. MEYER

MAP PREPARED AUGUST 2, 1991 BY GARY D. KAISER

ADDITIONS MAY 4, 1992 GPK

