


T.6S. R.1E. W.M.

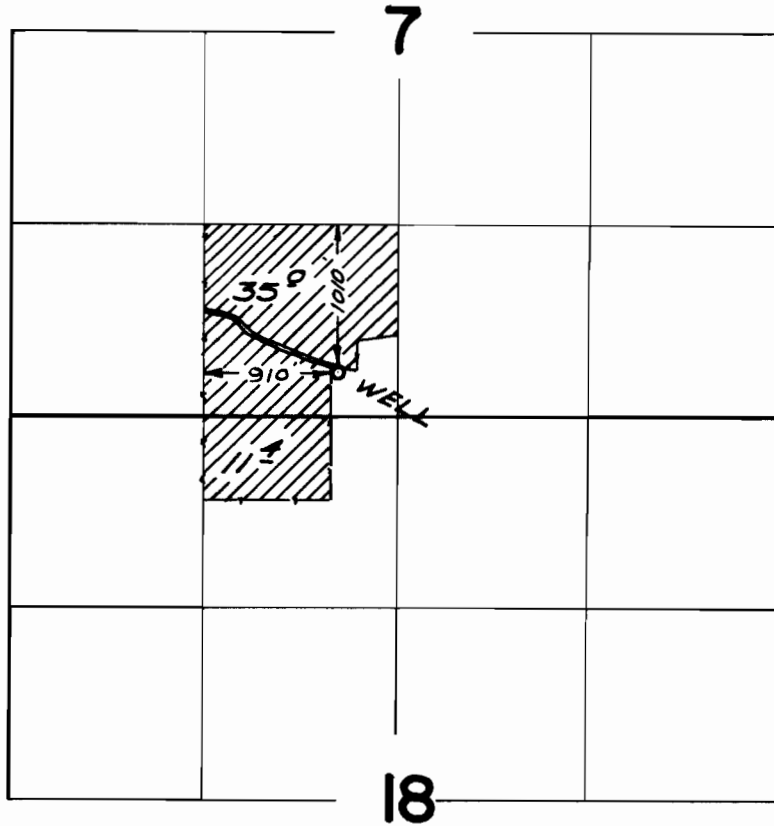

FINAL PROOF SURVEY UNDER

Application No. G-2568. Permit No. G-2377
IN NAME OF

PAUL DICKMAN

Surveyed Aug. 17, 1966, by V. GARNER