


T. 9 S., R. 21 E., W.M.

44419

RECEIVED

DEC 30 1994

WATER RESOURCES DEP
SALEM, OREGON

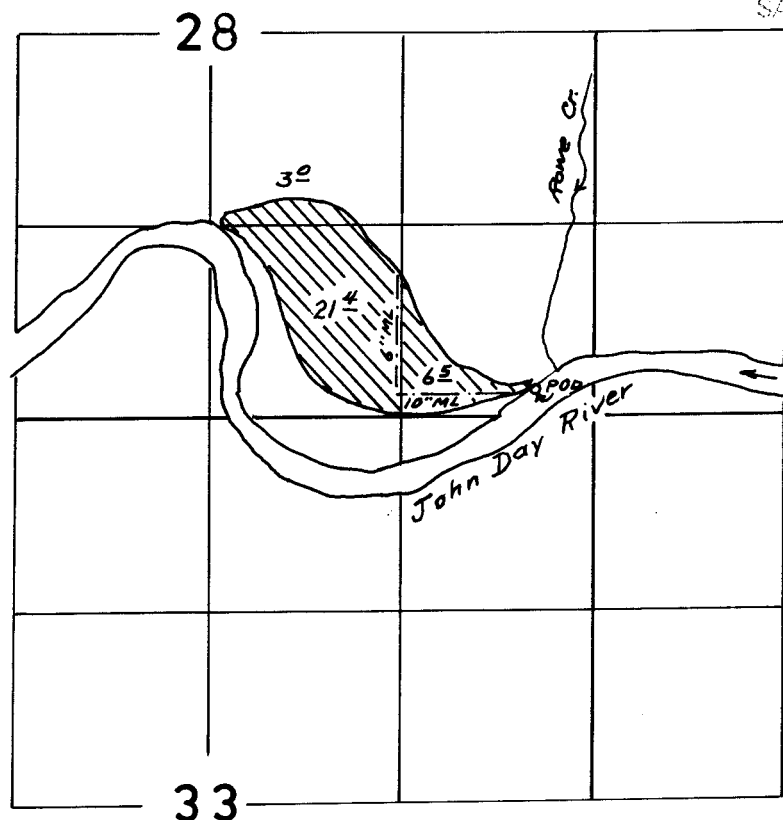

N

1" = 1320'

POD - 170' N. AND 390' W. FROM THE SE. CORNER,
SECTION 28.

FINAL PROOF SURVEY

UNDER

Application No. 58893 Permit No. 44419
IN NAME OF

TOM COLE

Surveyed 7-6, 1992, by J. MILLER