


T.28 S., R.12 W.W.M.
SECTION 7

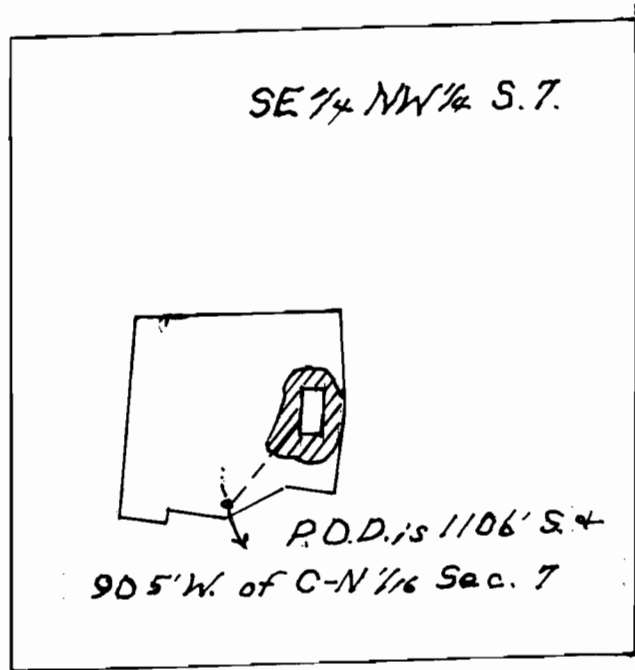

SCALE: 1" = 400'

FINAL PROOF SURVEY
UNDER

Application No. 69600

Permit No. 50449

IN Name of
Ellis N. Phillips
Surveyed May 8, 1992