


T. 27 S., R. 11 W., W. M.

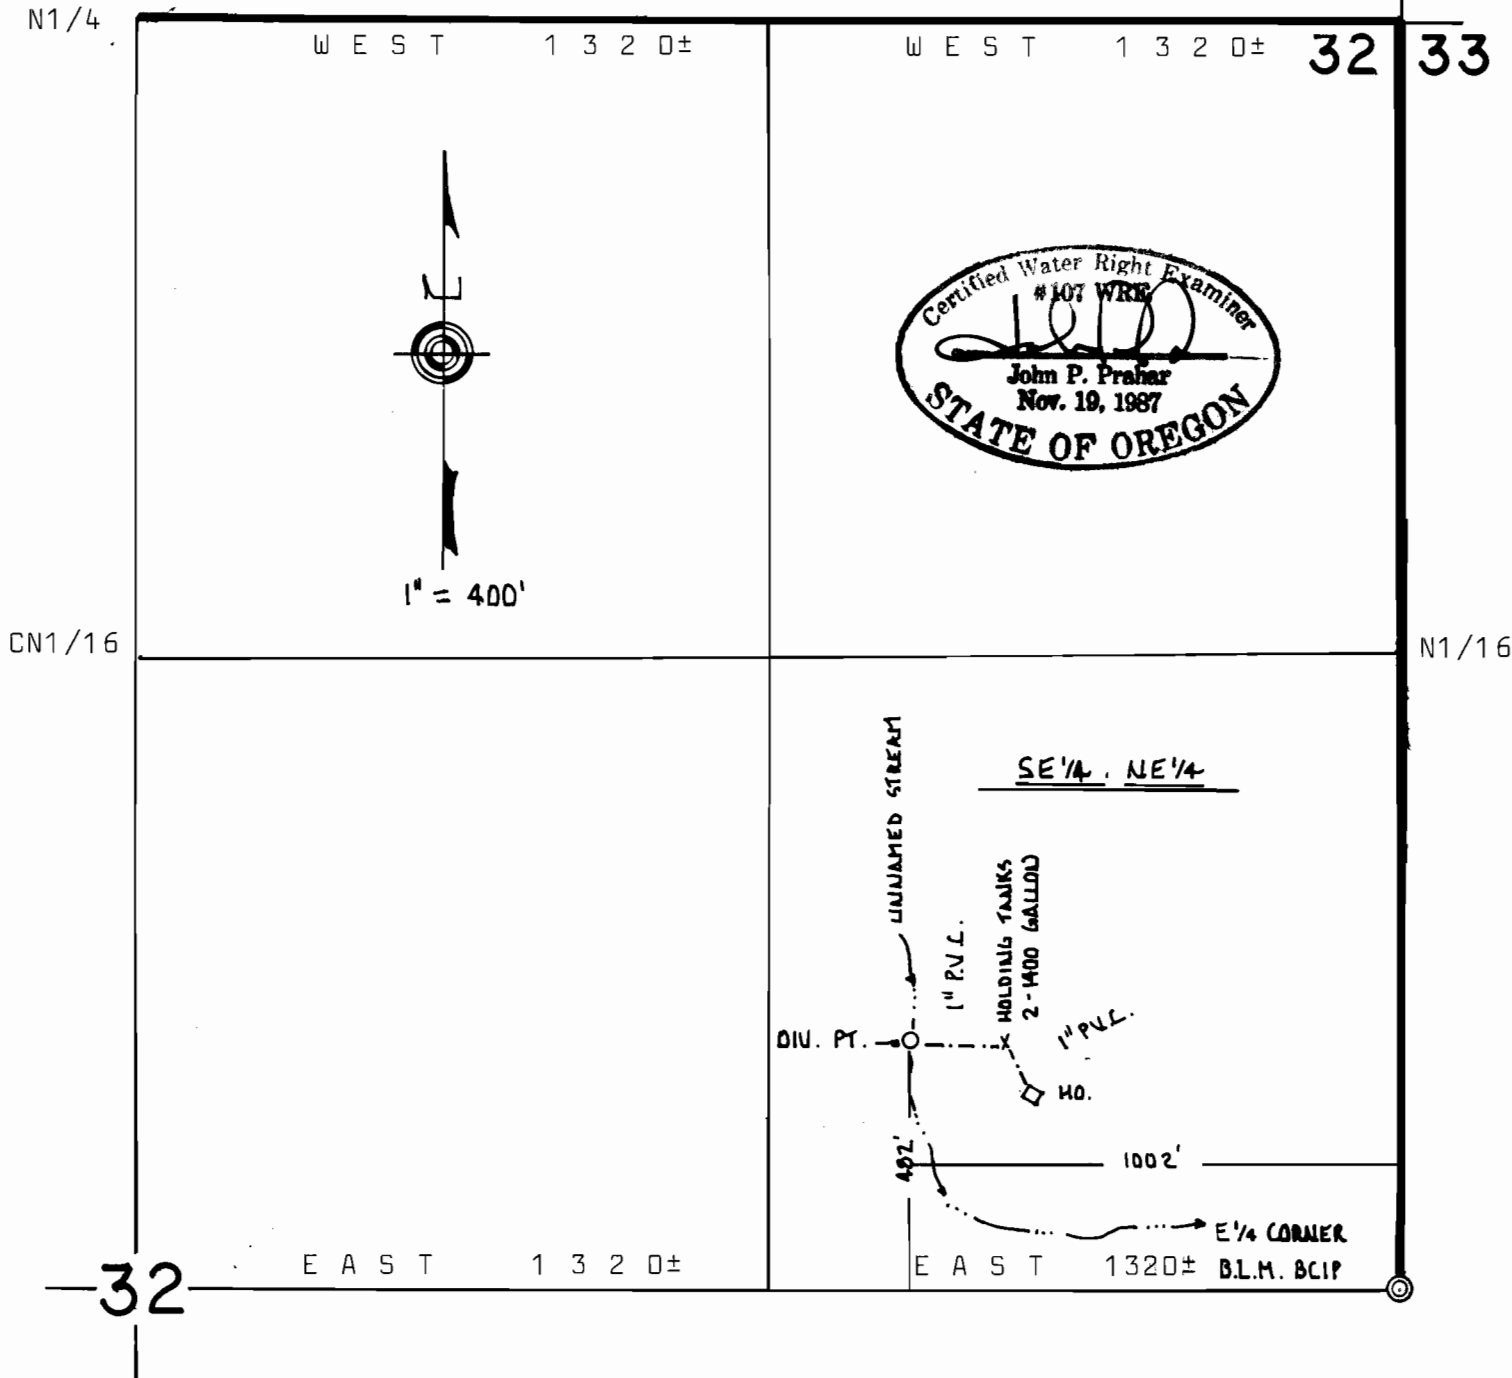

FINAL PROOF SURVEY  
UNDER  
APPLICATION NO 69634, PERMIT NO. 50532  
IN NAME OF  
THOMAS AND PATTY TIMOTHY, OWNERS

SURVEYED BY: John P. Prahar, CWRE#107, Aug. 18, 1992

This map was prepared for the sole purpose of locating a water right and is not intended to show ownership or property lines.