


SECTION 25, T.33S., R.15W., W.M.

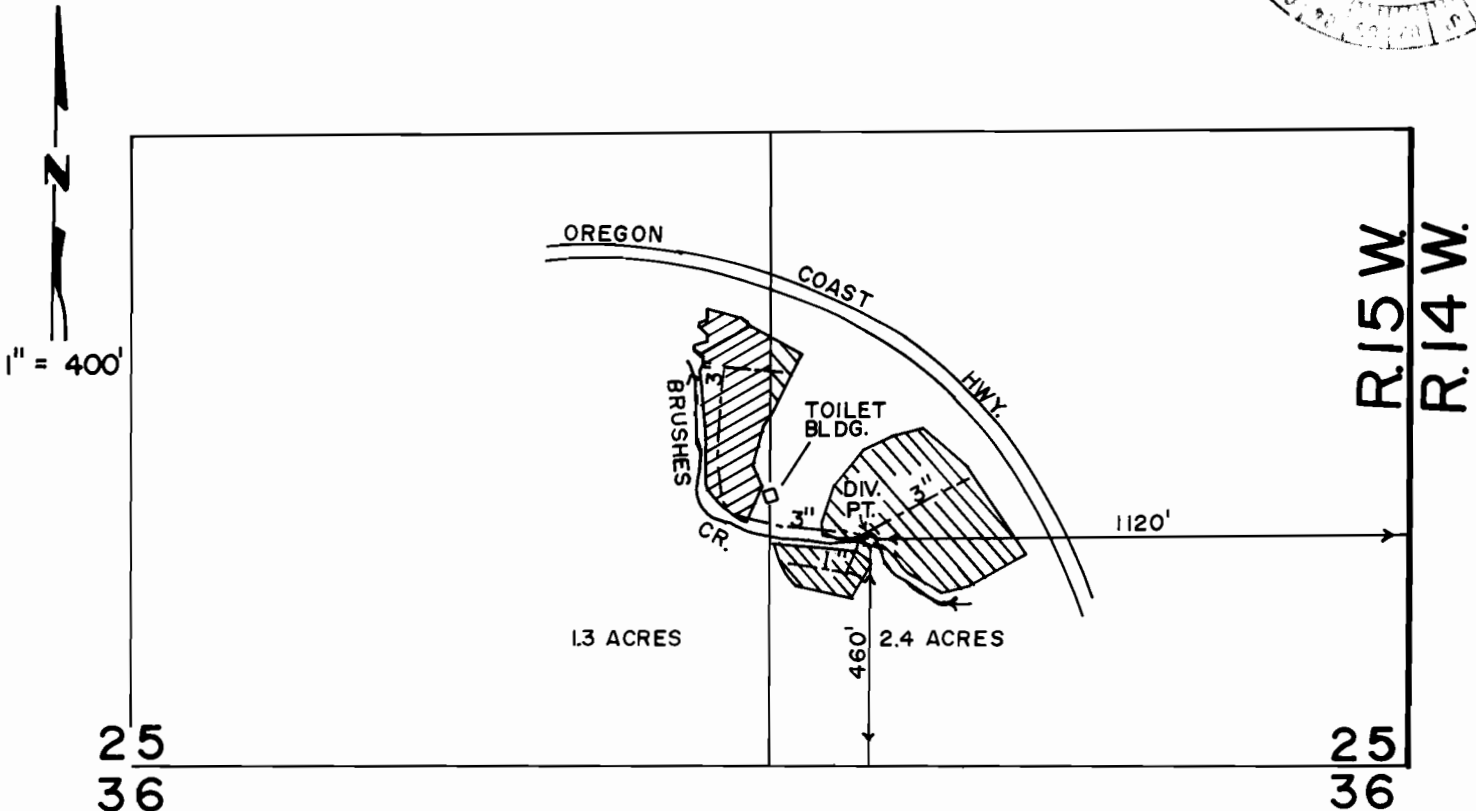

FINAL PROOF SURVEY UNDER

Application No. 69981 Permit No. 50695

IN NAME OF

OREGON STATE PARKS DEPARTMENT

Surveyed 8-26, 1992

by PAUL D. ROGERS

THE PURPOSE OF THIS MAP IS TO IDENTIFY THE LOCATION OF THE WATER RIGHT. IT IS NOT INTENDED TO PROVIDE INFORMATION RELATIVE TO THE LOCATION OF PROPERTY OWNERSHIP BOUNDARY LINES.

