



T.19S.,R.5W.,W.M.,
SECTION 15

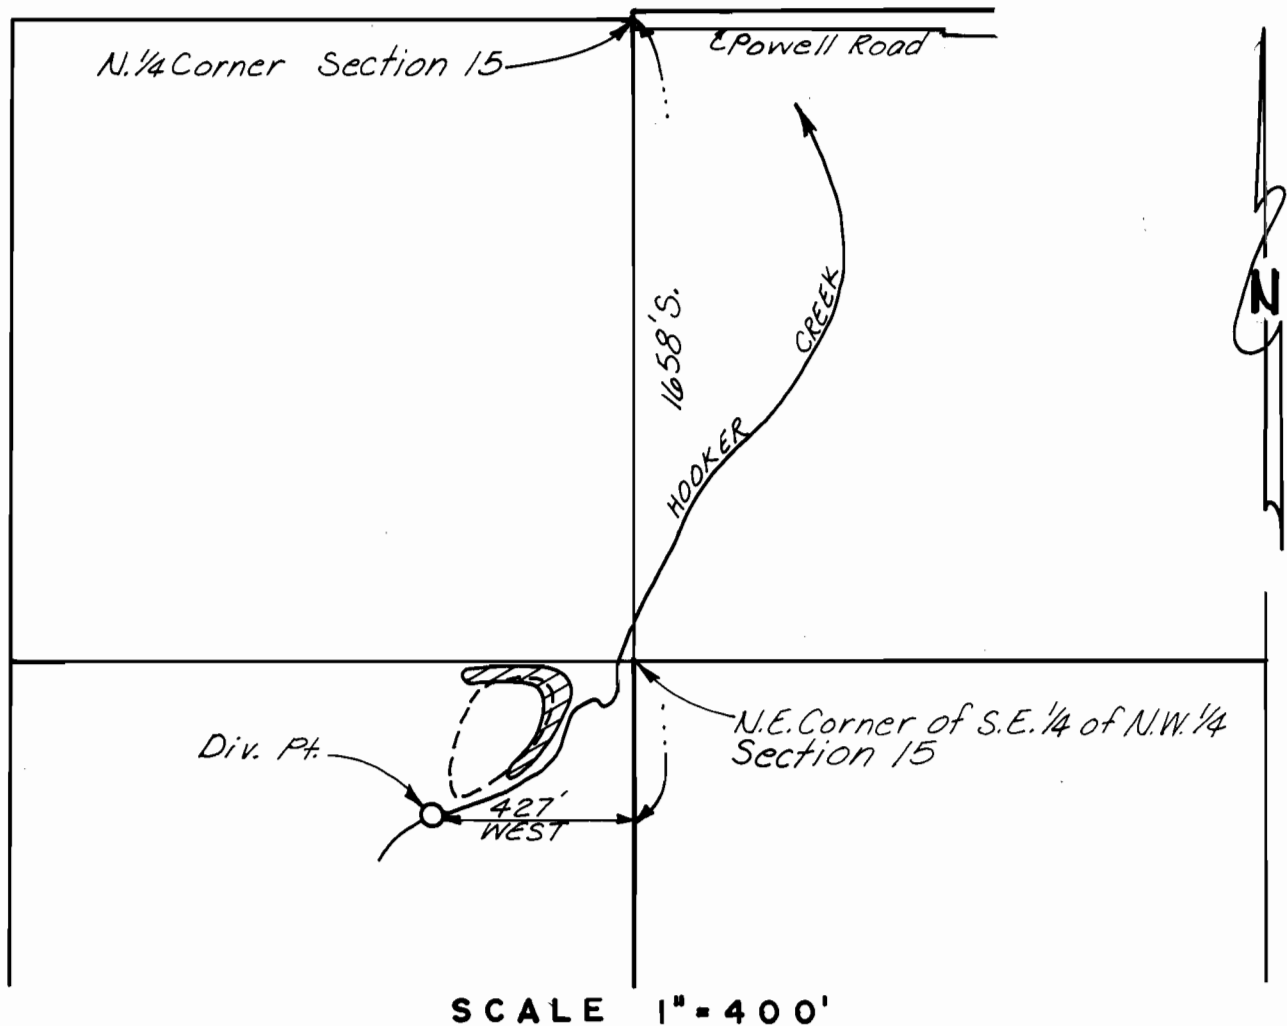

FINAL PROOF SURVEY
UNDER

Application No. R-70038 Permit No. R-11159
IN NAME OF
BILL ROSKAM

Surveyed Sept. 27, 1991, by [Signature]

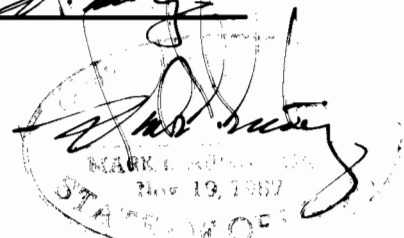

THIS MAP FOR WATER RIGHT PURPOSES ONLY.
THIS MAP DOES NOT CONSTITUTE A BOUNDARY SURVEY.

9-27-91