


SECTION 7, T30S, R3W, WM

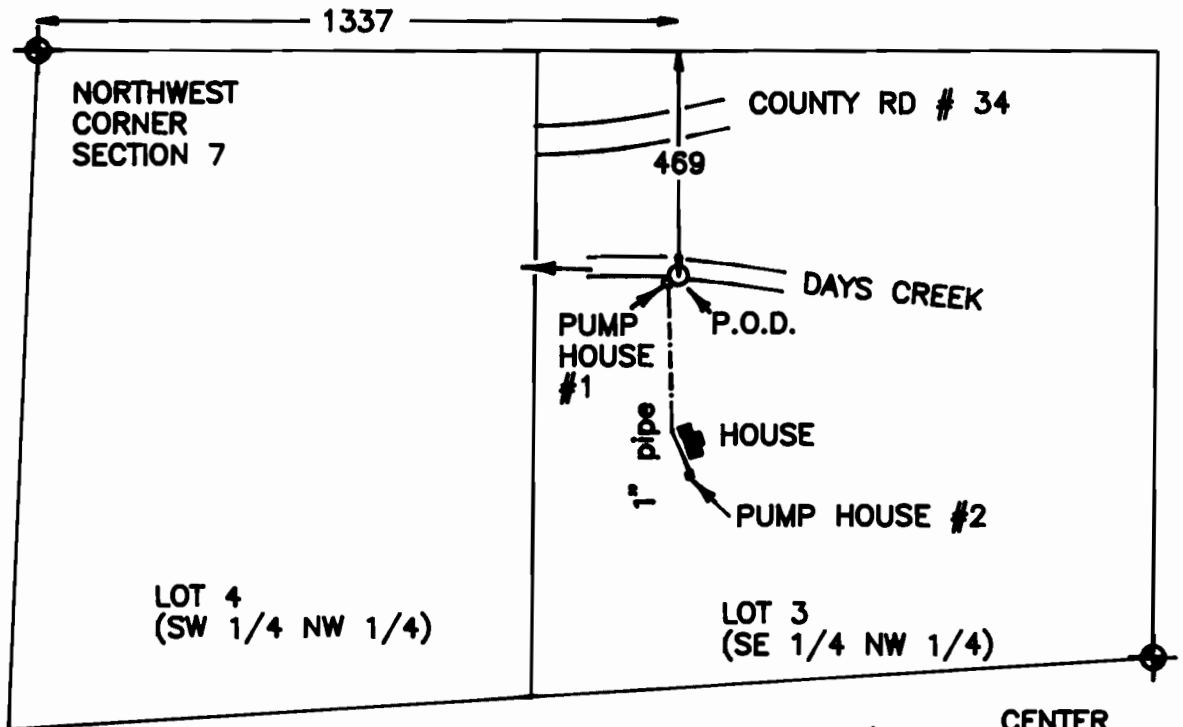

THIS MAP IS TO BE USED FOR
WATER RIGHT PURPOSES ONLY

SURVEY AND SECTION SUBDMISION
BASED ON MONUMENTS FOUND PER
SURVEY M88-36 COUNTY SURVEYORS OFFICE

0 400 800

SCALE

FINAL PROOF SURVEY

IN NAME OF
LeRoy Fralick

DATE APRIL 25, 1992

BY: WILLIAM J. RUPPERT
P.O. BOX 1564
MYRTLE CREEK, OR 97457



Appl. # 70291

Permit # 51125