


T. 30 S., R. 12 W. W. M.

Scale: 1" = 1320'

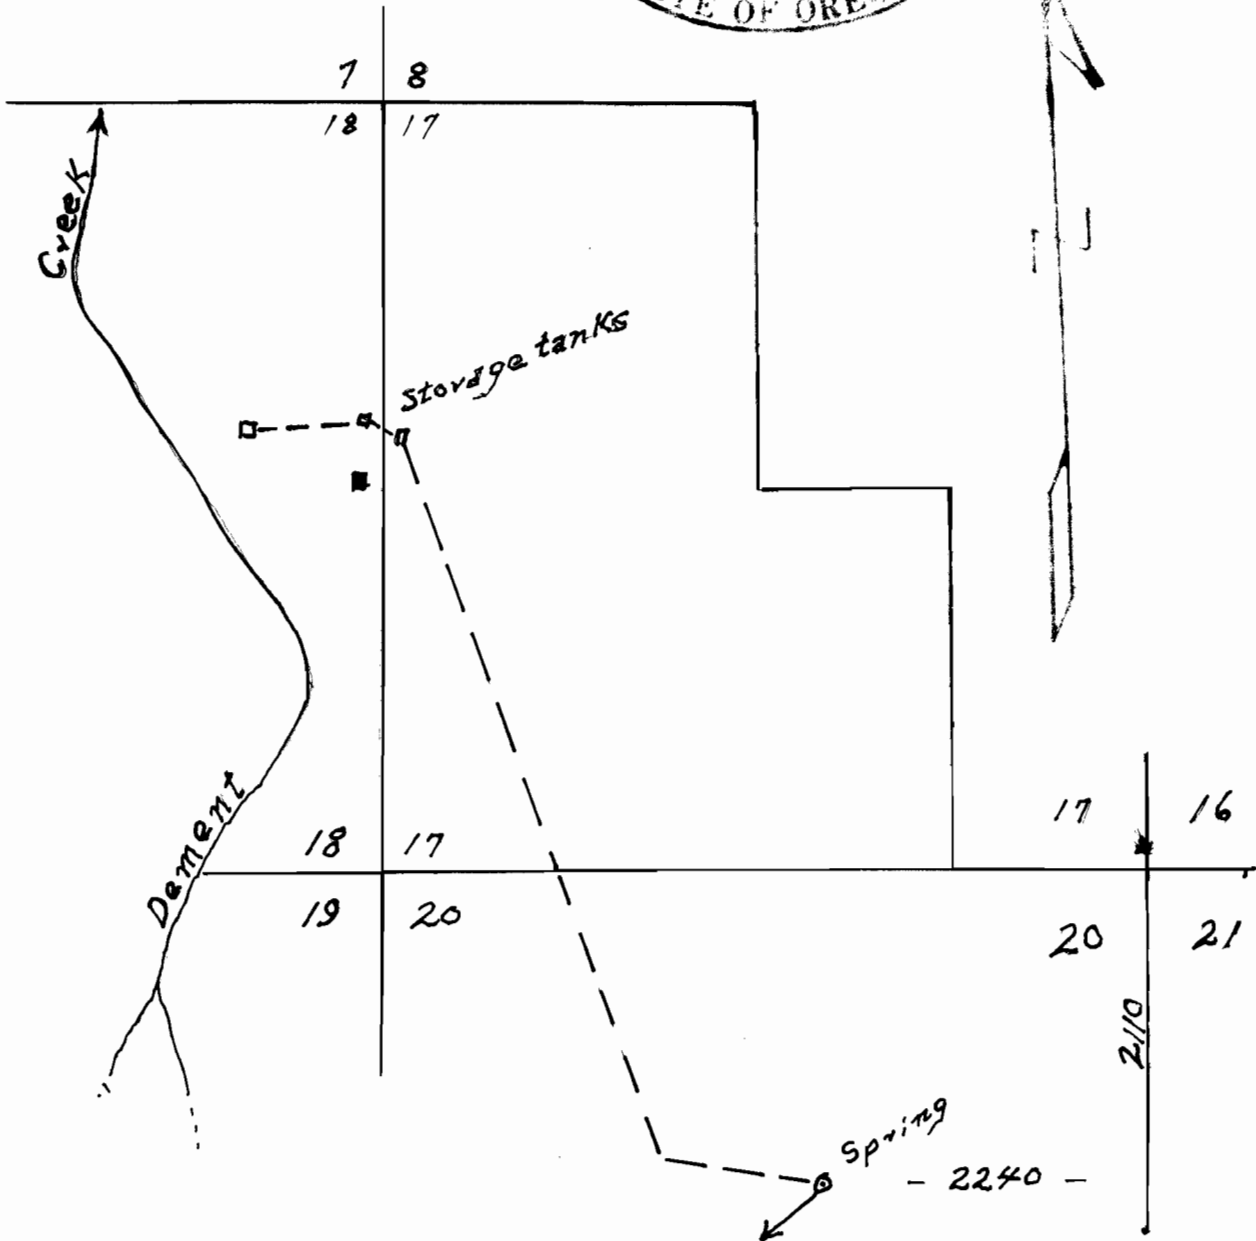

FINAL PROOF SURVEY
Under

Application No. 70923

Permit No. 51385

Surveyed Aug. 22, 1992 by: F. J. Hales.