


T. 9 S. R. 40 E. W. M.

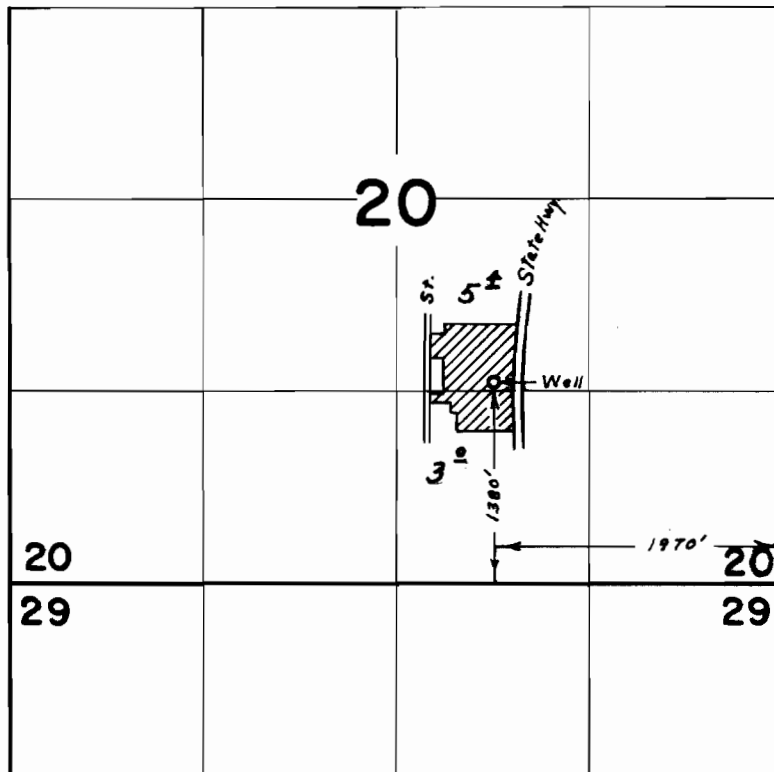

FINAL PROOF SURVEY UNDER

Application No. G-4859 Permit No. G-4548
IN NAME OF

STUART G. & HELEN J. FRENCH

Surveyed Aug. 6., 1970, by L. E. Gould.