


TOWNSHIP 3 S., RANGE 4W

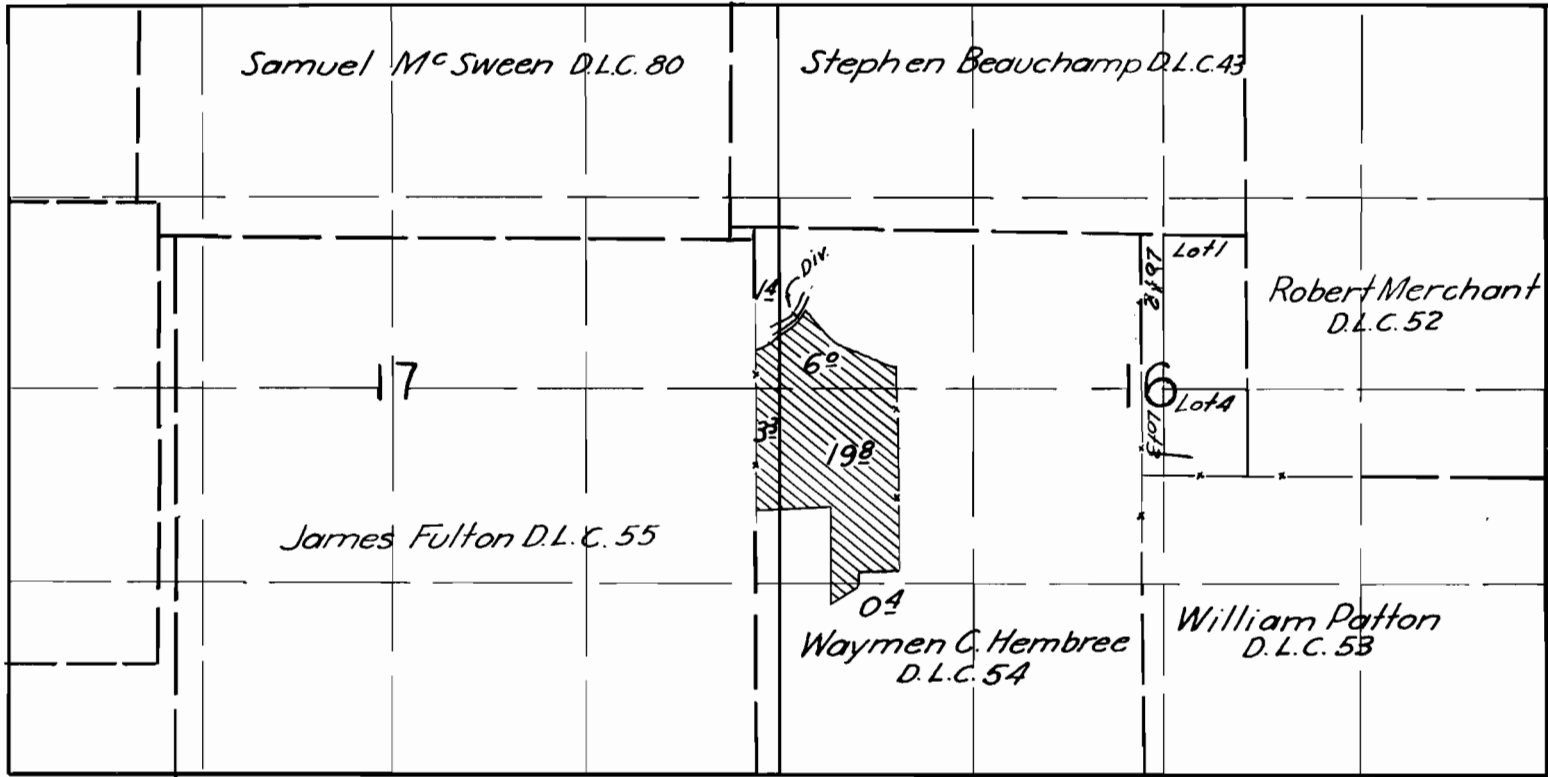

**FINAL PROOF SURVEY**

UNDER

Application No. 17660 Permit No. 13354

IN NAME OF

H.E. Grastle

Surveyed Apr. 28, 1941, by Ed Cummings