


T.16 S., R.3 W., W.M.
 SECTIONS 16 & 21
 FINAL PROOF MAP T-7005
 MUDDY CREEK IRRIGATION PROJECT
 LANE COUNTY, OREGON

RECEIVED

MAR 21 1996
 WATER RESOURCES DEPT
 SALEM, OREGON

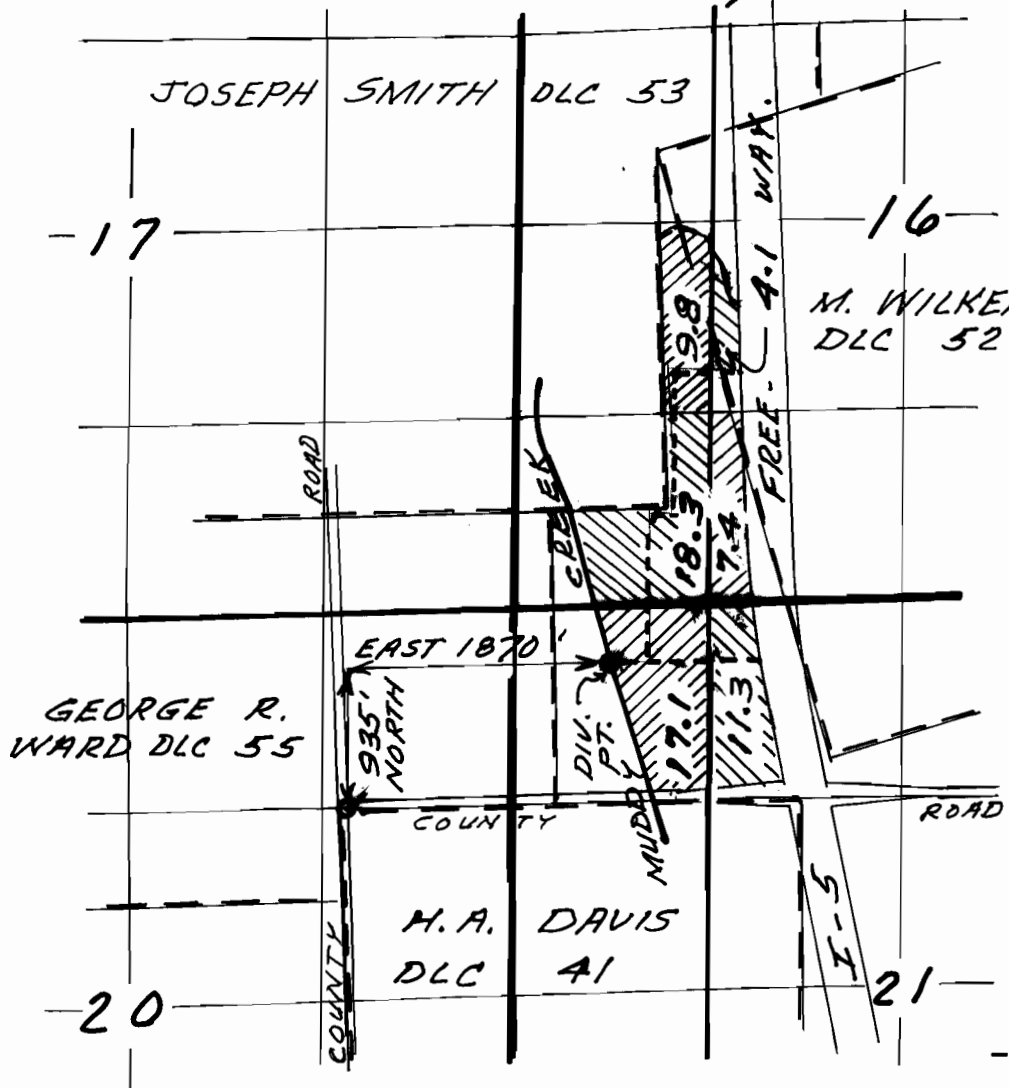


SCALE
 1" = 1320'
 MARCH 21, 1994

--- = MAIN LINE


THIS MAP IS FOR WATER RIGHT
 PURPOSES ONLY AND IS NOT
 INTENDED TO PROVIDE DIMENSIONS
 FOR LOCATING PROPERTY BOUNDARIES.

TRANSFER T-7005
 SURVEYED FEBRUARY 3, 1994
 BY CHARLES W. GUILÉ

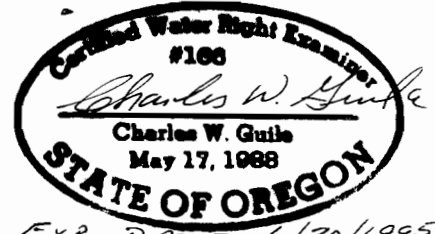

CHARLES W. GUILÉ
 & ASSOCIATES, CO.
 Land Surveying
 62 Columbia Loop
 Eugene, OR 97401

92-41 E