


T. 2S. R. 2W. W.M.

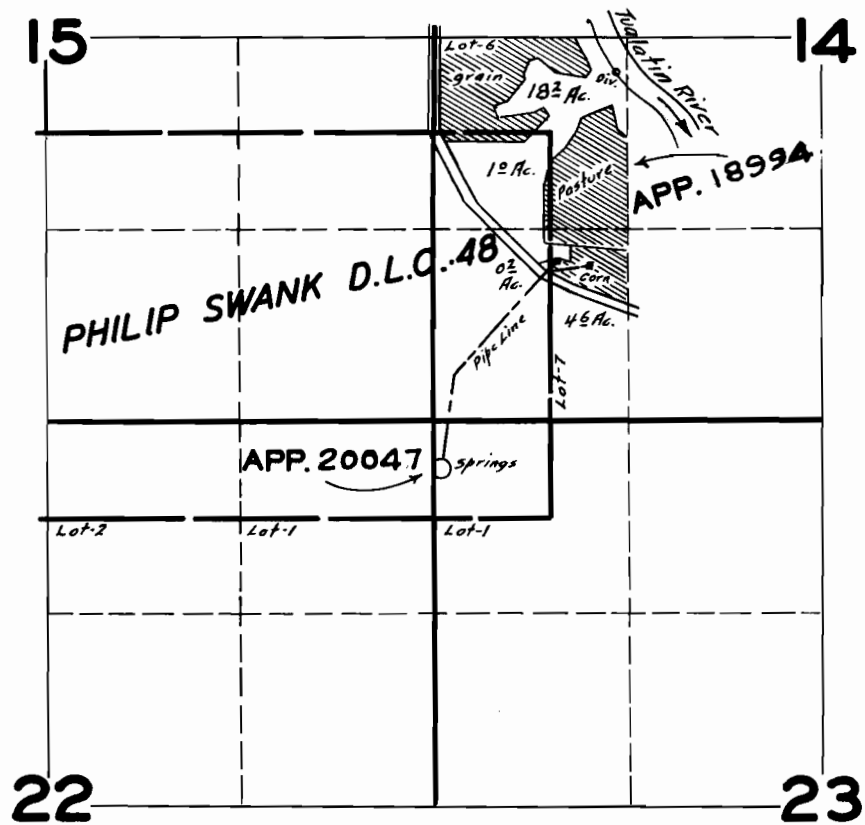

FINAL PROOF SURVEY

UNDER

18994

14610

Application No. 20047 Permit No. 15614

IN NAME OF

R.E. SCHORZMAN

Surveyed AUG. 20 1946, by