


T.2N.R.3W.W.M.

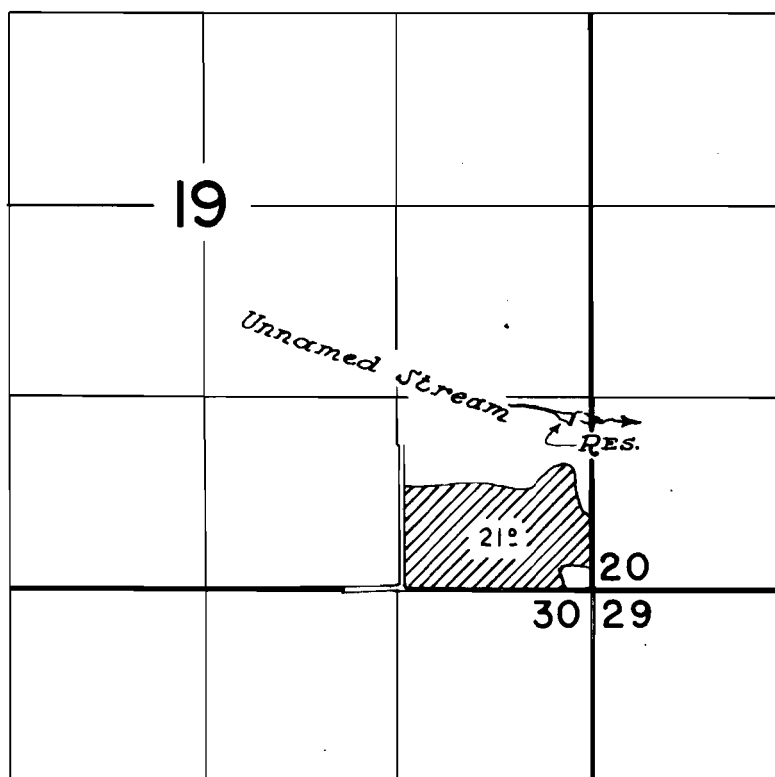

FINAL PROOF SURVEY
UNDER

Application No. R-31101 31102 Permit No. R-1942 24513
IN NAME OF

VERNON B. & MAUDE E. BATEMAN

Surveyed August 3 1960, by

St Jackson