



T. 2 N., R. 30 E., W.M.

G-6044
72231

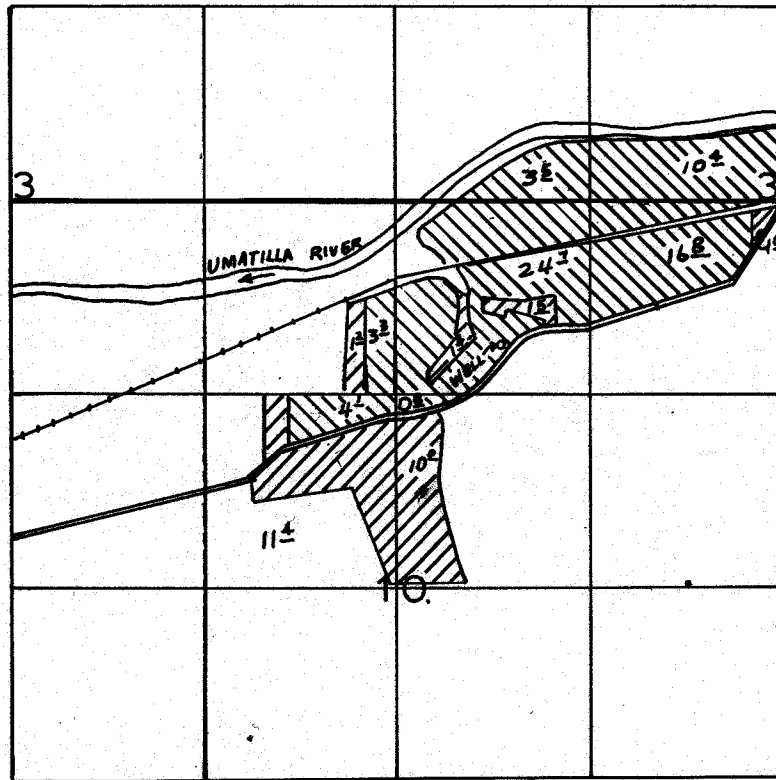

 PRIMARY

 SUPP'L

WELL LOCATED 975' S. AND 750' E. FROM THE
NORTH 1/4 CORNER SECTION 10.

FINAL PROOF SURVEY

UNDER

Application No. G-6441 Permit No. G-6044
IN NAME OF

THEODORE A. HENDRICKSON

Surveyed 1/27, 1994, by J. MILLER