

Form AI-187
March 1961

UNITED STATES
DEPARTMENT OF THE INTERIOR
BUREAU OF LAND MANAGEMENT

SECTION


32

NW 1/4 NE 1/4

Oregon State Water Filings

TOWNSHIP 35S, RANGE 20E, W. M.

North

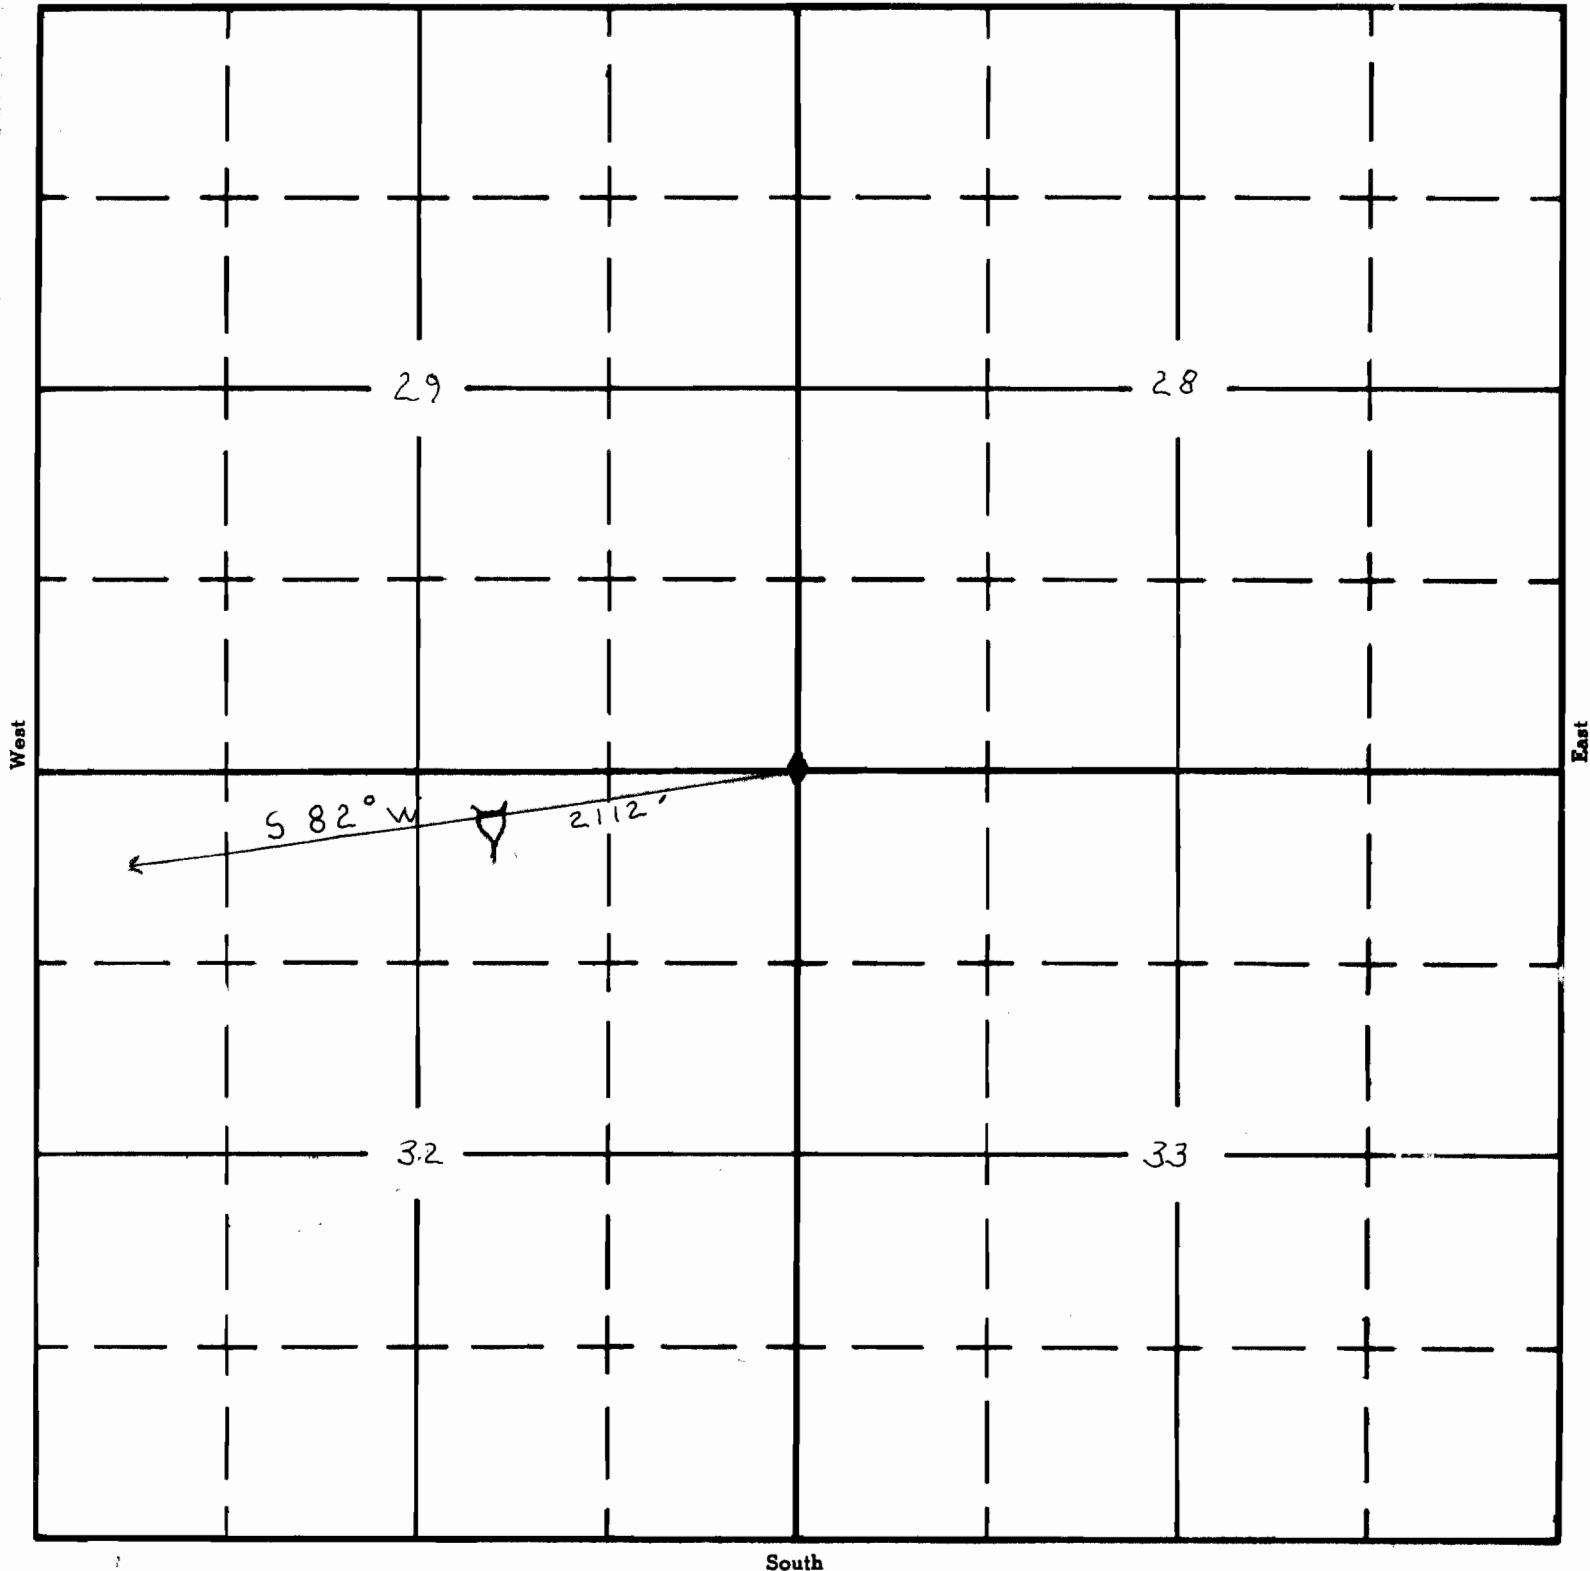

APPLICATION No. R-35126
PERMIT No. R-2833