


UNITED STATES
DEPARTMENT OF THE INTERIOR
BUREAU OF LAND MANAGEMENT

SECTION 8
NE SE

Oregon State Water Filings

TOWNSHIP 24 S, RANGE 37 E, W. M.

North 5199 Anhydrous

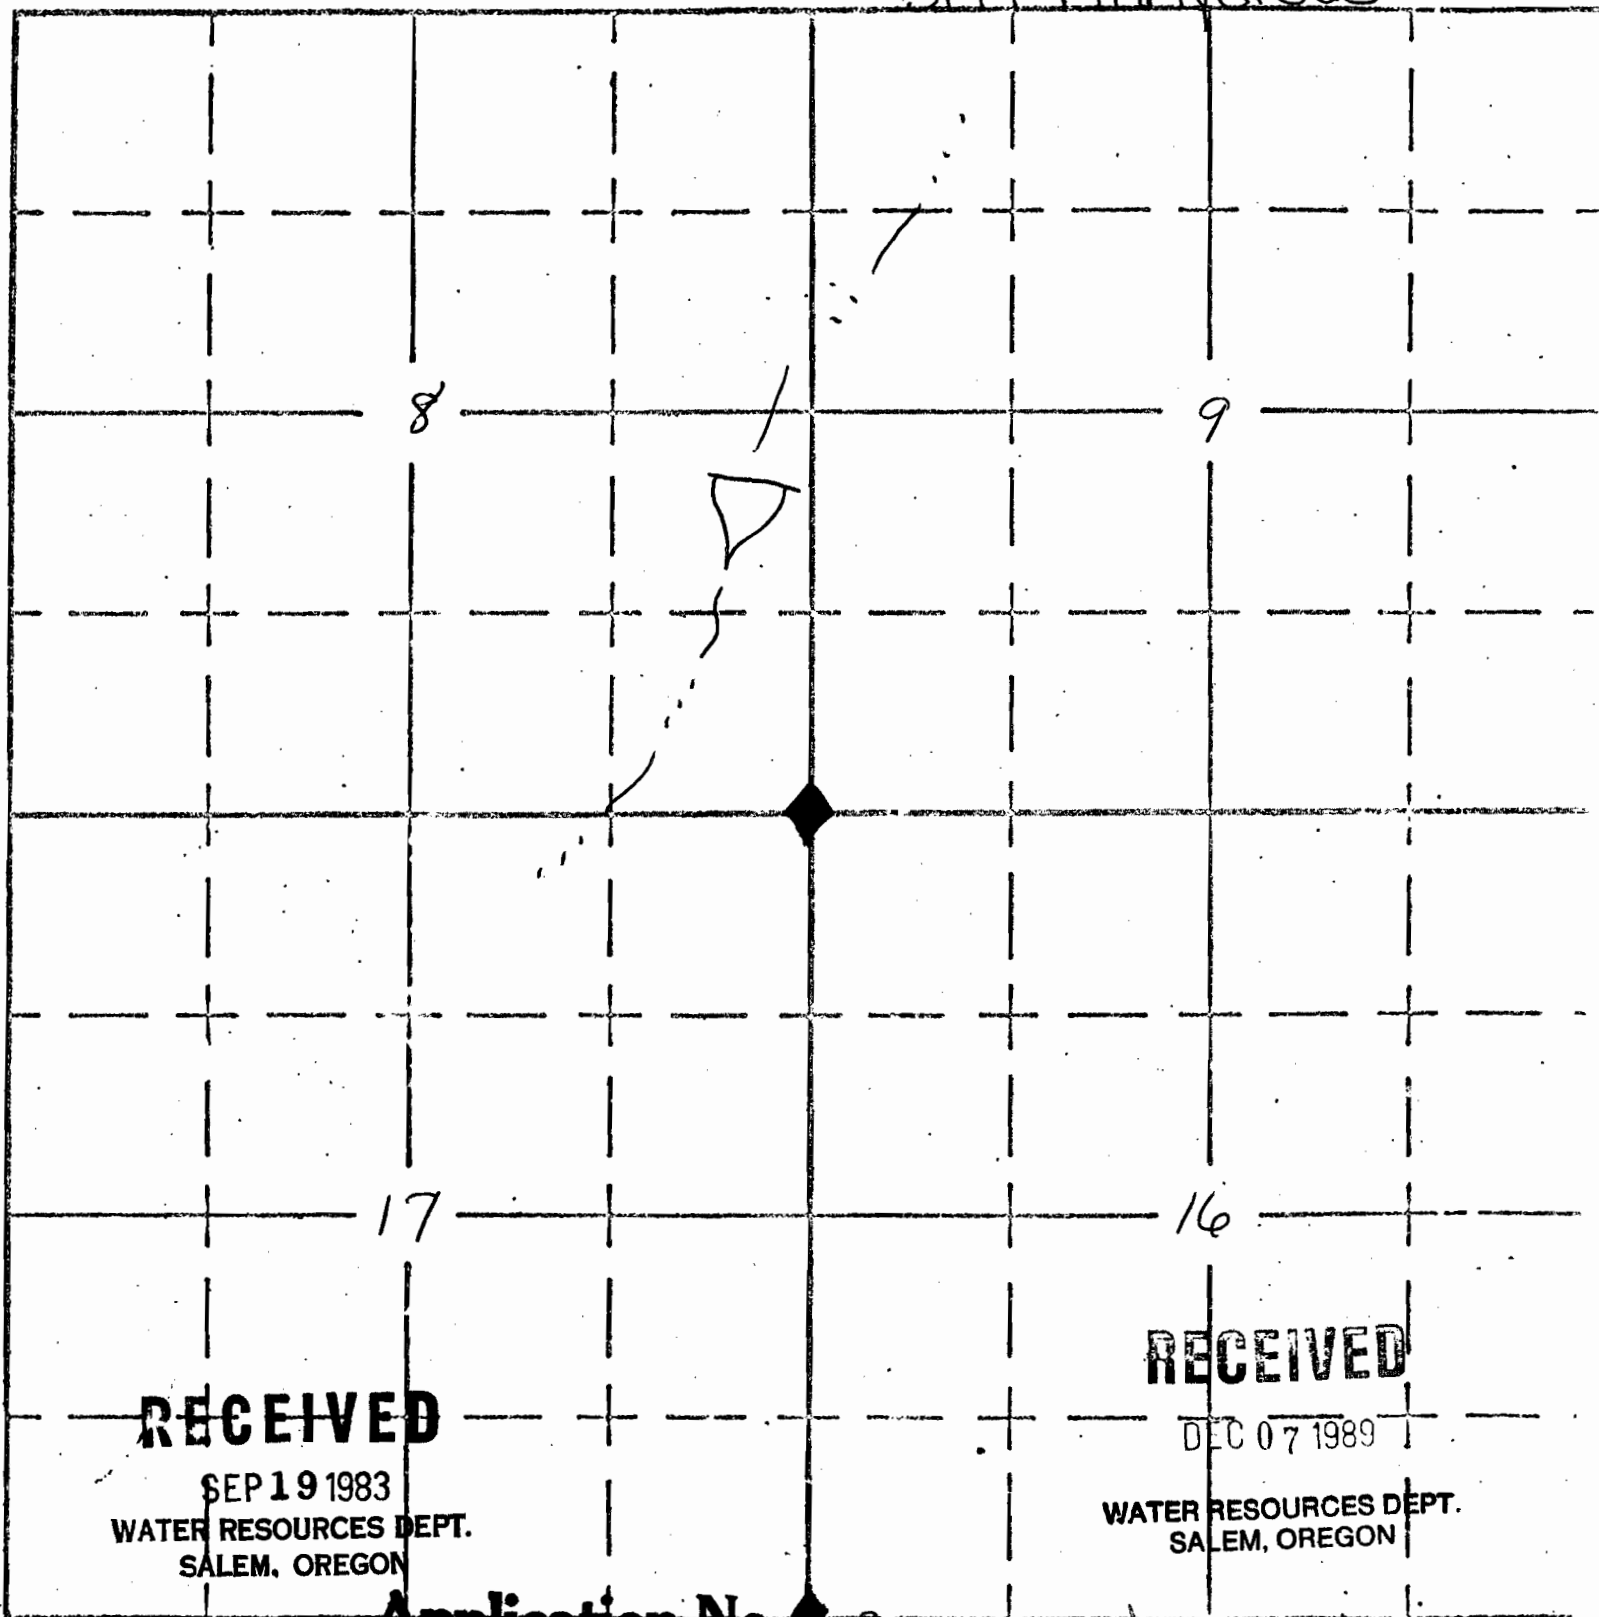

RECEIVED

SEP 19 1983
WATER RESOURCES DEPT.
SALEM, OREGON

RECEIVED

DEC 07 1989
WATER RESOURCES DEPT.
SALEM, OREGON

Application No. R-66180
Permit No. R11449

Superseded
APPLICATION No.