

T4N, R5W, W.M.

COLUMBIA COUNTY, ORE.


SCALE 1"=400'

FINAL PROOF MAP

UNDER
RICHARD E. COOK




NW 1/4 SECTION 12

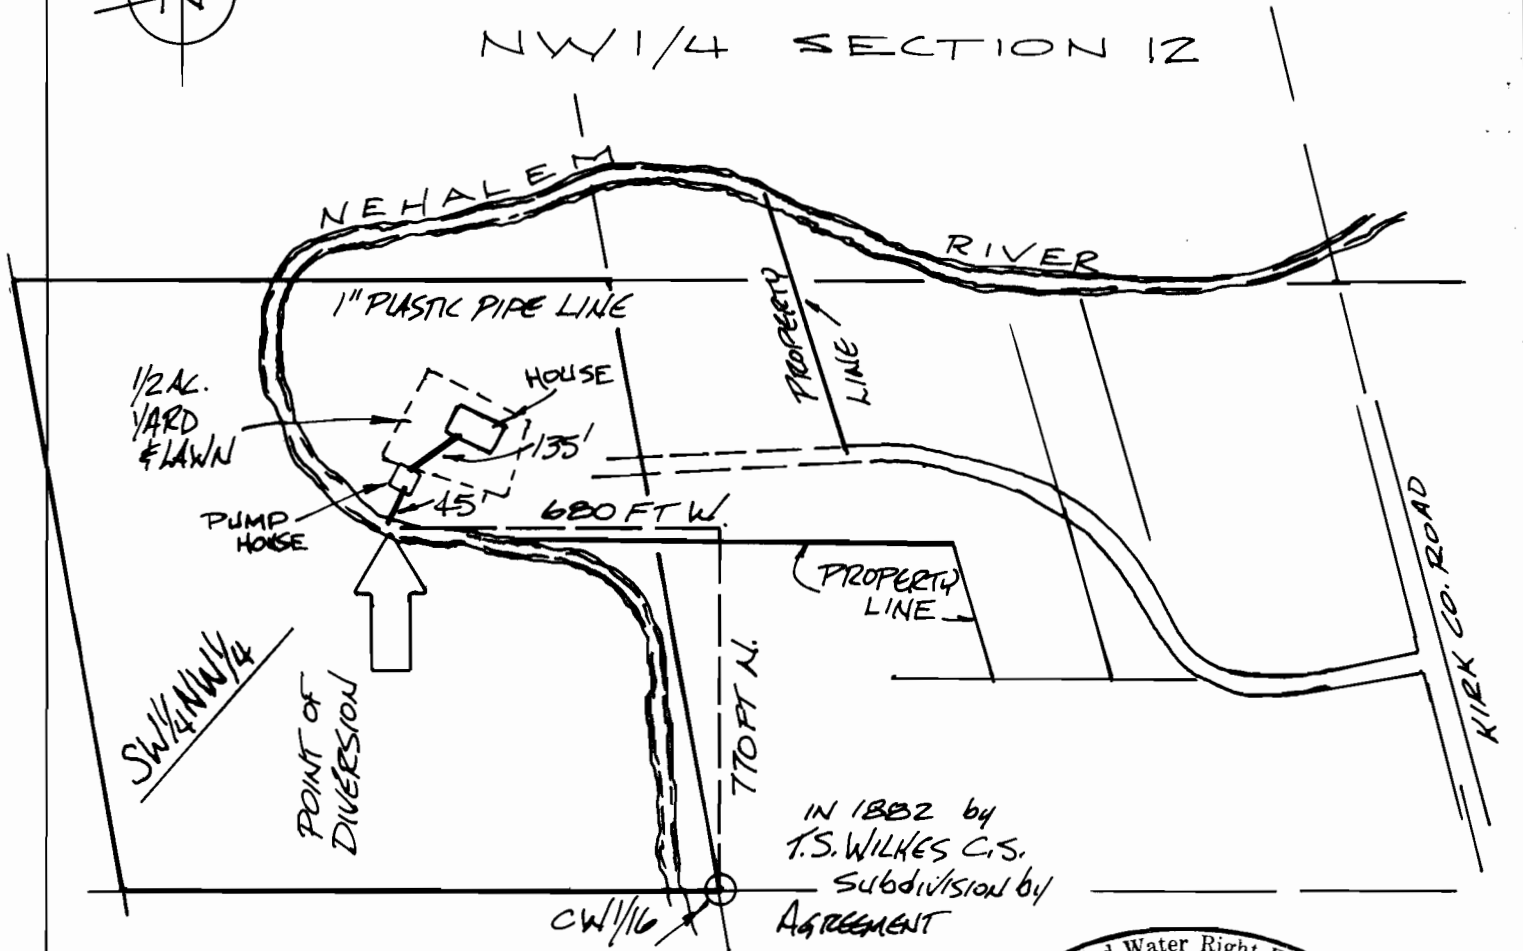

IN 1882 by
T.S. WILKES C.S.
Subdivision by
AGREEMENT

BY: L.G. KEENON
1311 ALDER
VERNONIA, ORE. 97064

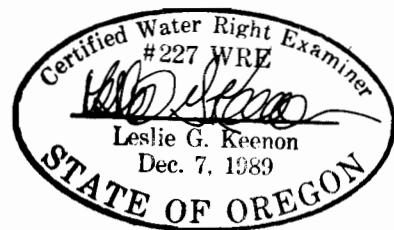

AUG 28, 1992