


SE1/4 SW1/4 SEC. 23, T. 40 S., R. 9 W., W. M.

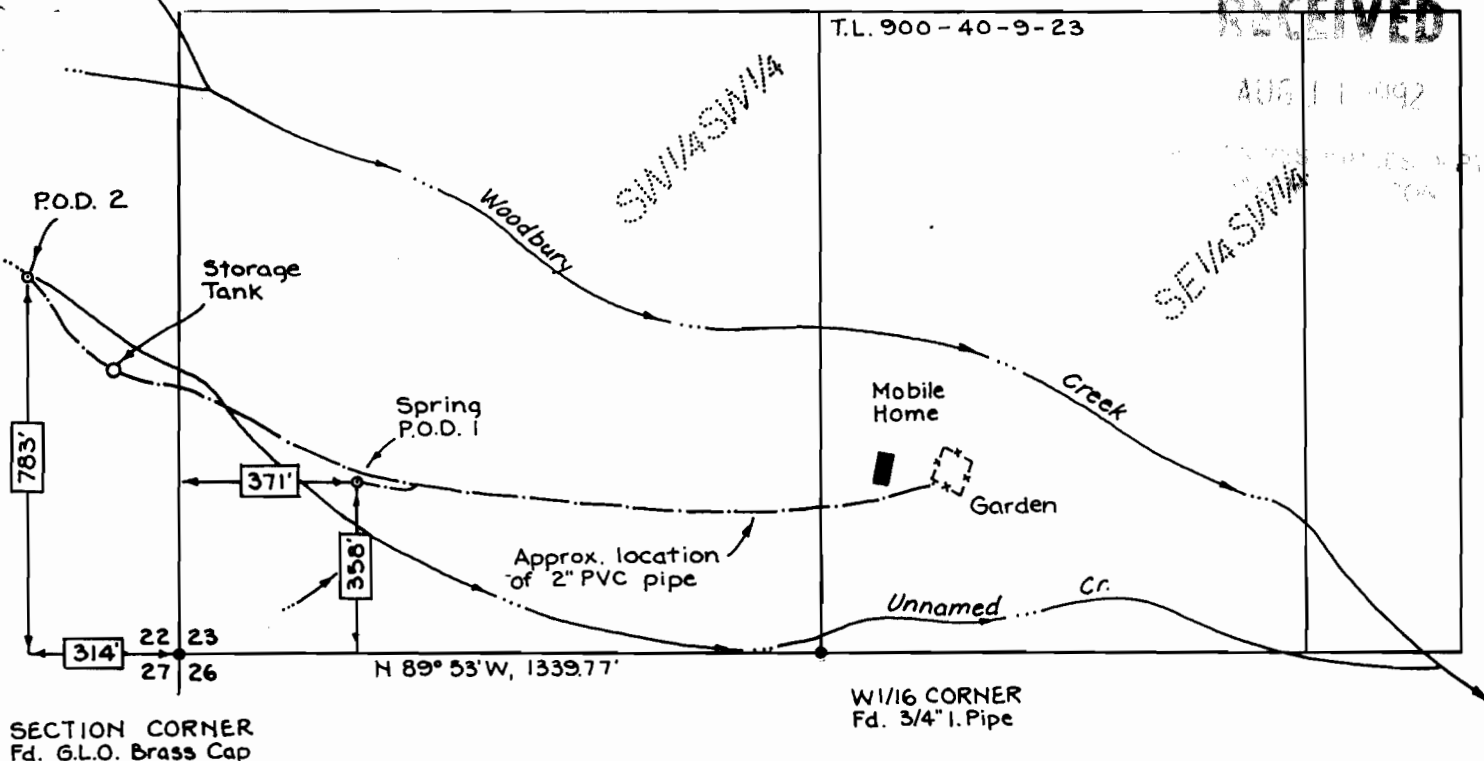


SECTION CORNER
Fd. G.L.O. Brass Cap

THE TIES TO THE DIVERSION POINTS ARE BASED UPON A RECORD BEARING OF N 89° 53' W FOR THE SOUTH LINE OF SECTION 23 PER SURVEY NO. 85-65. SURVEY TIES WERE MADE USING A WILD T-1600 THEOMAT WITH A DISTOMAT DI-1000 E.D.M.I.

THIS PLAT WAS PREPARED FOR THE PURPOSE OF IDENTIFYING THE LOCATION OF THE WATER RIGHT PER PERMIT NO. 50243. THERE IS NO INTENT TO PROVIDE DIMENSIONS OR LOCATIONS OF PROPERTY OWNERSHIP LINES.

A THREE PAGE SITE REPORT ACCOMPANIES THIS PLAT.

SUBJECT PROPERTY: TAX LOT 900, MAP NO. 40-9-23.

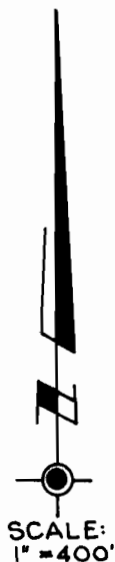

PROJECT NO.
233-92-178

DRAWING NO.
37-8.5.11

DATE
July 13, 1992

SCALE
1" = 400'



PLAT OF
CLAIM OF BENEFICIAL USE
LOCATED IN
SE1/4 SW1/4 SECTION 23, T. 40 S., R. 9 W., W. M.
JOSEPHINE COUNTY, OREGON

PREPARED FOR:
Richard A. & Glenda D. Butts
P. O. Box 402
O'Brien, Oregon 97534

Tel. 596-2969

PREPARED BY:
GARY D. WICKS, P.E., P.L.S.
CIVIL ENGINEER & LAND SURVEYOR
962 SE "N" STREET
GRANTS PASS, OREGON 97526

Tel. 479-3436