


SECTION 1 T. 2S., R. 3W., W.M.
WASHINGTON COUNTY, OREGON


RECEIVED

AUG 11 1992


1/4 COR

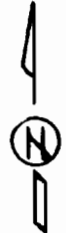

SCALE: 1" = 400'

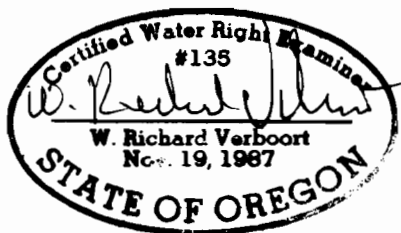

PREPARATION OF THIS MAP IS FOR THE PURPOSE OF IDENTIFYING THE LOCATION OF THE WATER RIGHT ONLY. THERE IS NO INTENT TO PROVIDE DIMENSIONS OR LOCATION OF PROPERTY OWNERSHIP LINES.

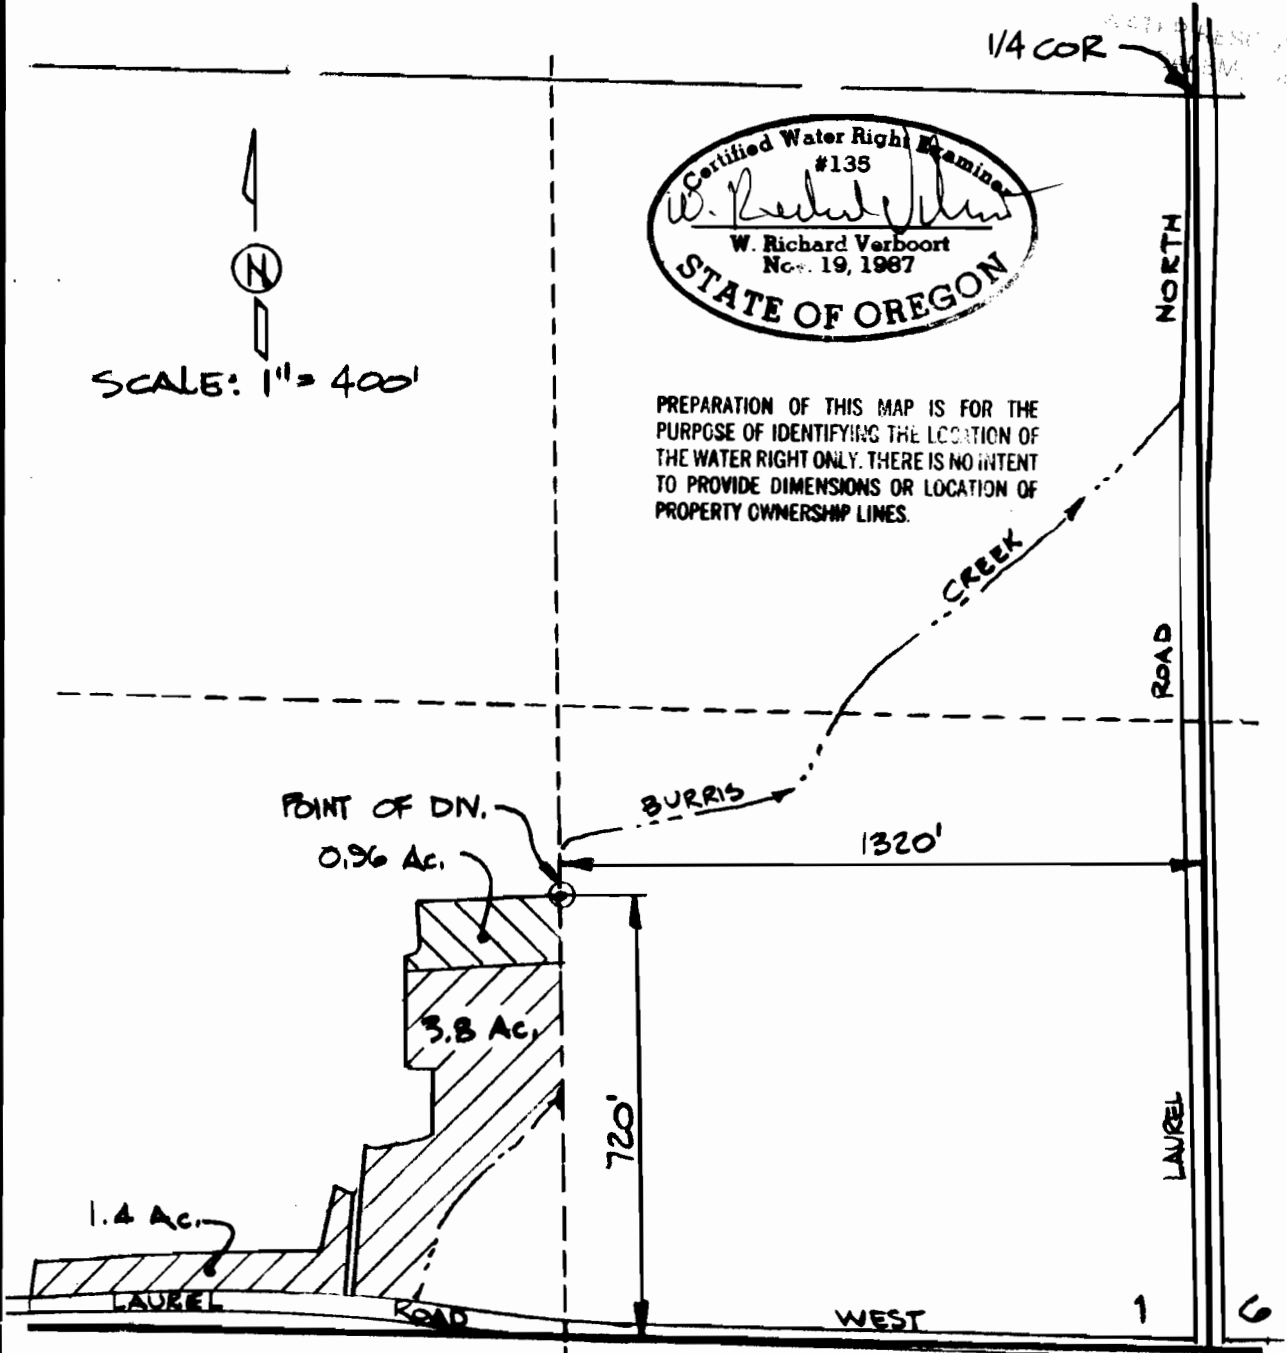

FINAL PROOF SURVEY

T-6191
SURVEYED JULY 28, 1992

VERBOORT ENGINEERING
AGRICULTURE · CIVIL · WATER RESOURCES
HILLSBORO, OREGON

by date
designed WRV 8-92
drawn YR 8-92
checked WRV 8-92
drawing no. 92-A-09
sheet no. 1/1

RICHARD EGGER
31181
3181 S. W. LAUREL RD.
HILLSBORO, OR 97123