


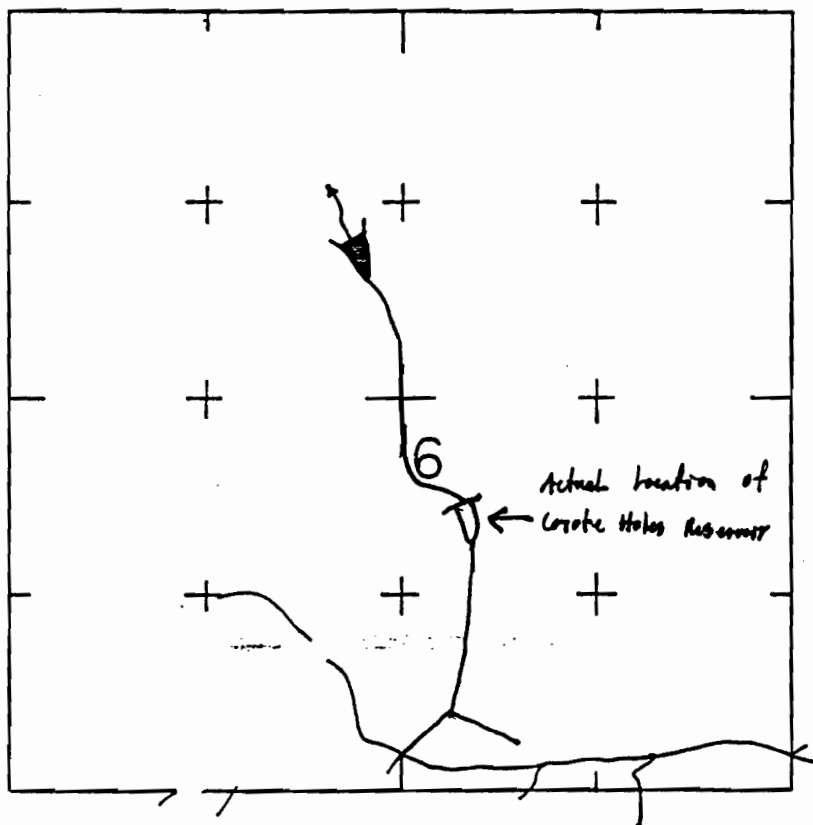

R-114799-100
R 7333

RECEIVED
JUN 10 1968
STATE ENGINEER

U. S. DEPARTMENT OF THE INTERIOR
BUREAU OF LAND MANAGEMENT

COYOTE HOLES RES
SE 4 NW 4 SEC 6 T35S R44E
W. M.

DESIGNED _____	RECOMM. _____
DRAWN <i>Rim</i>	RECOMM. _____
CHECKED _____	APPROVED _____

CHIEF, DIV. OF ENG.

SCALE 4" = 1 mi

DATE June 10, 68

SHEET 1 OF 1

DRAWING NO.