


UNITED STATES
DEPARTMENT OF THE INTERIOR
BUREAU OF LAND MANAGEMENT

SECTION 21
SWSE

Oregon State Water Filings

TOWNSHIP 40^S, RANGE 39^E, W. M.

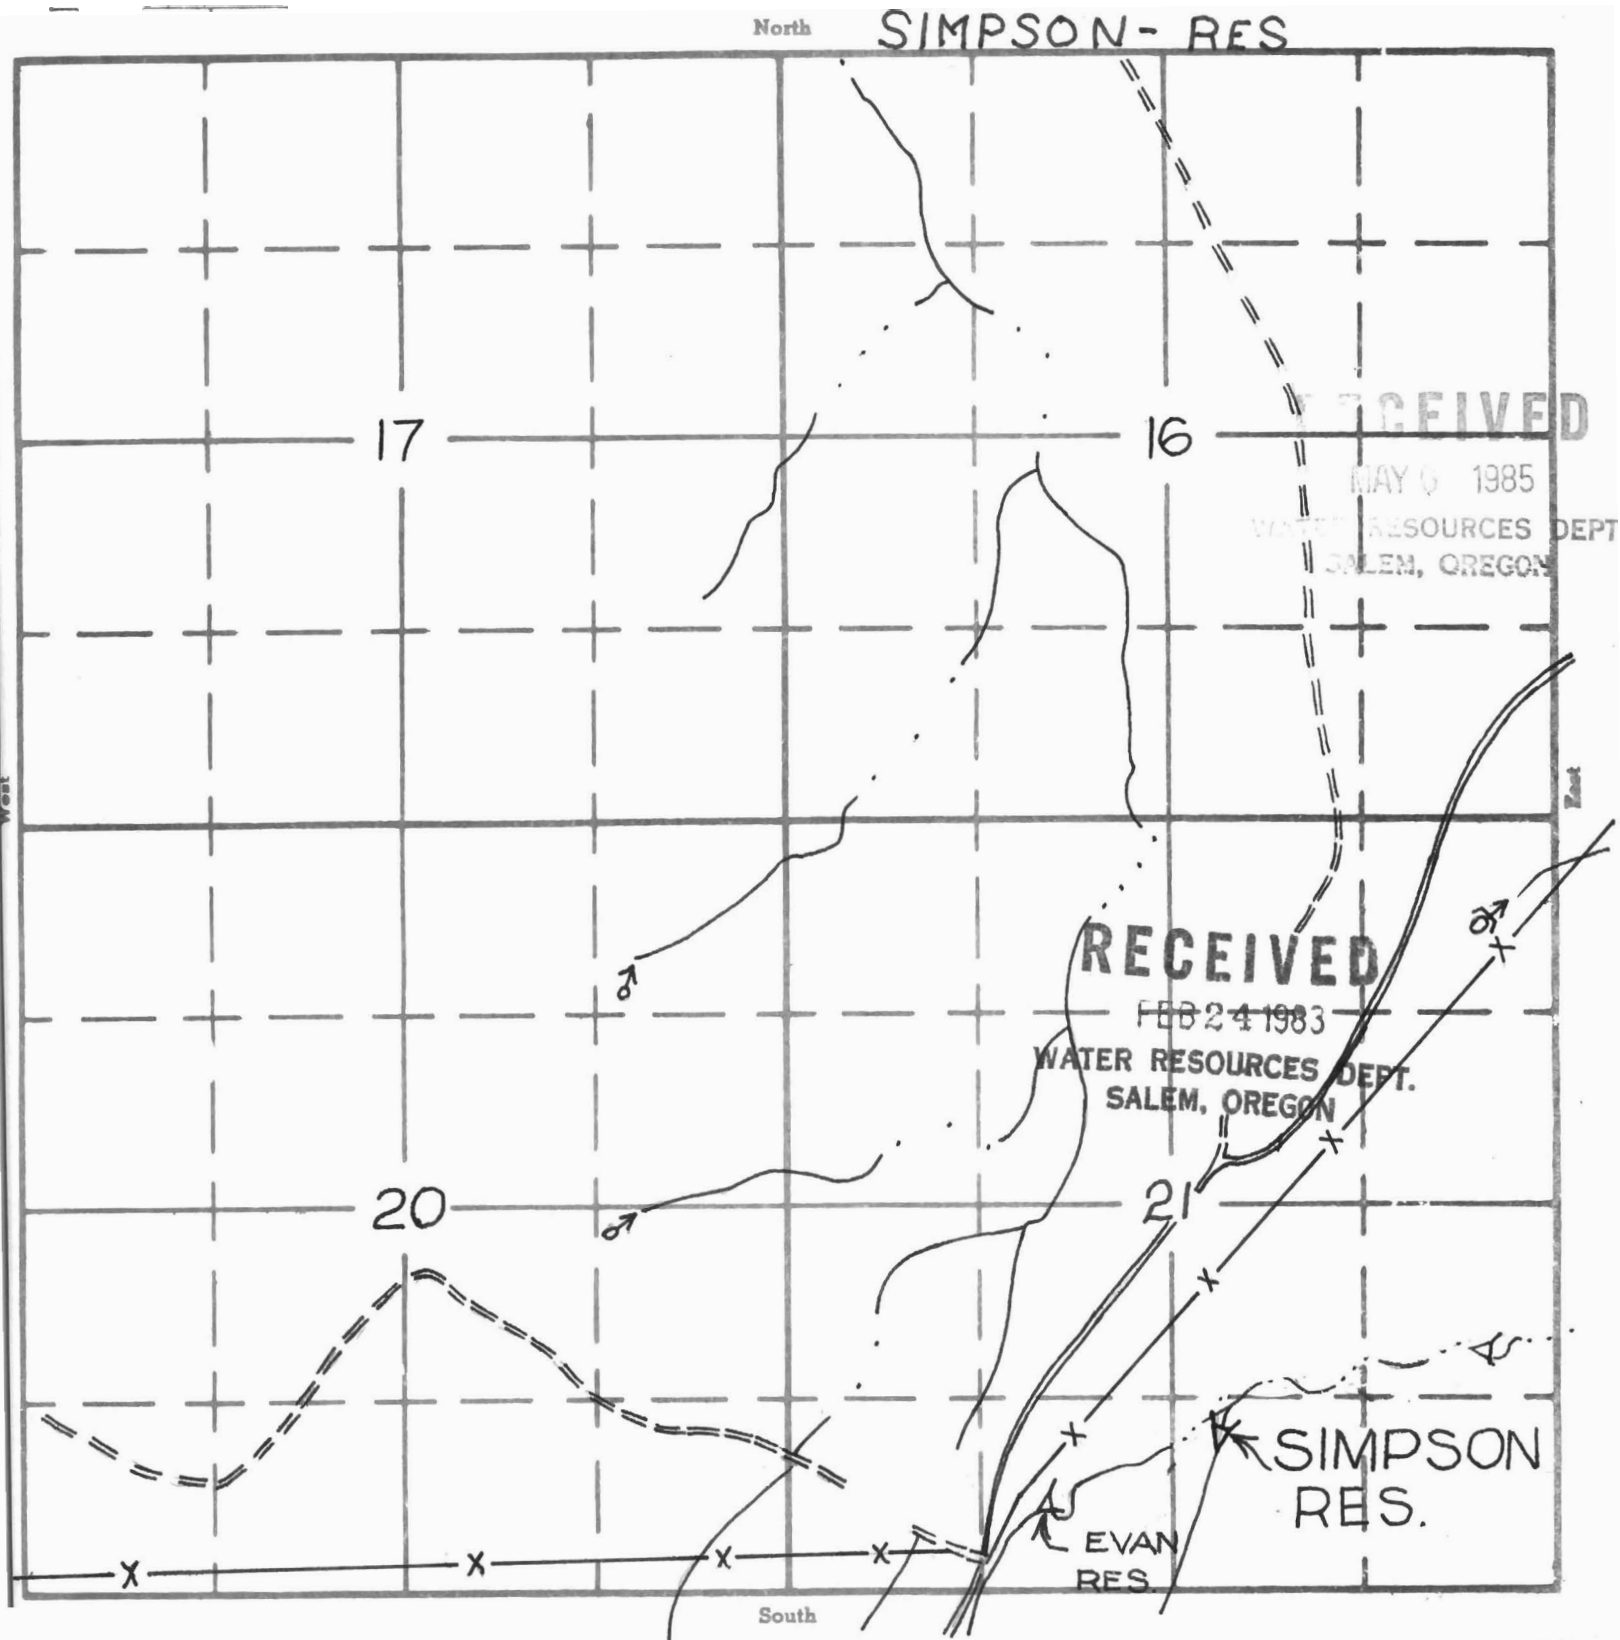

APPLICATION No. 59059
PERMIT No. R10515