


SECTION 19

NE $\frac{1}{4}$ SE $\frac{1}{4}$

TOWNSHIP 37S RANGE 41E W.M.

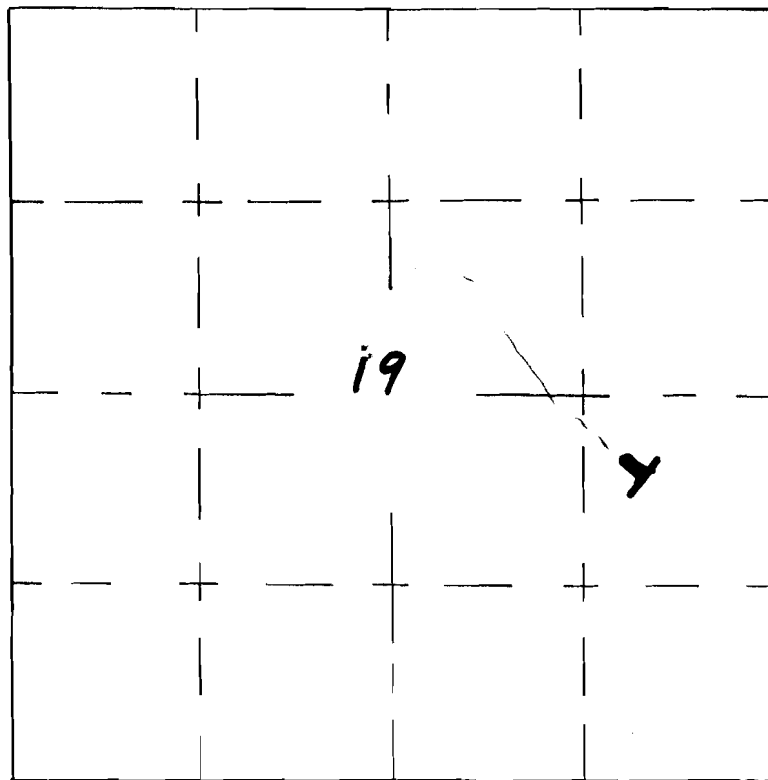

Blue Mtn. Basin


Nº R59140

Permit No. R 8773

SECTION 19

~~NE $\frac{1}{4}$~~ ~~SE $\frac{1}{4}$~~
SE $\frac{1}{4}$ NE $\frac{1}{4}$

TOWNSHIP 37S RANGE 41E W.M.

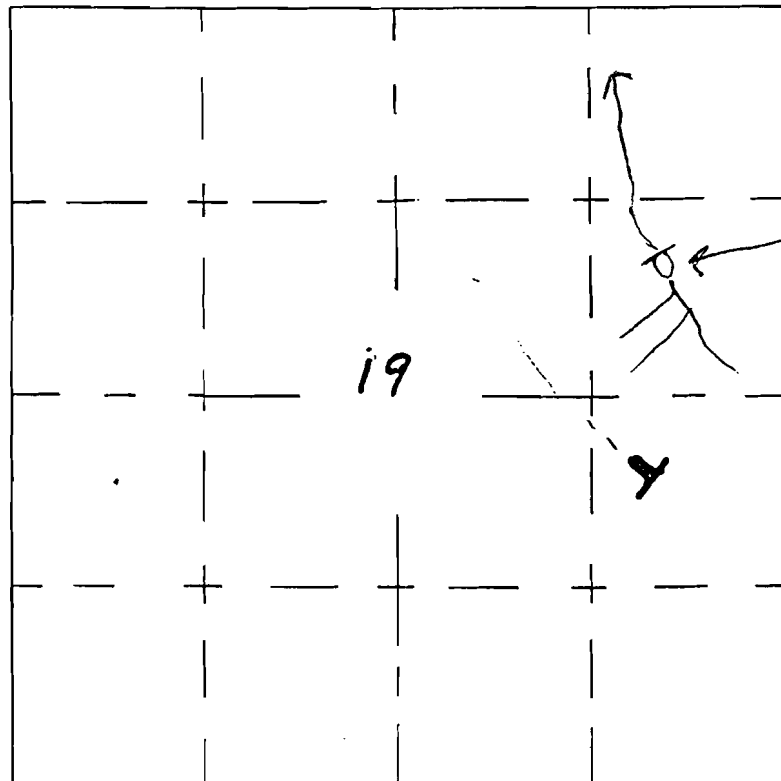

Actual location of
Blue Mountain Basin
#2 Reservoir

Blue MTN. Basin

Nº R 59140

Permit No. R 8773