


RECEIVED
APR 17 1979
WATER RESOURCES DIVISION
WASHINGTON, D.C. 20240

T. 37 S. R. 43 E. W.M.

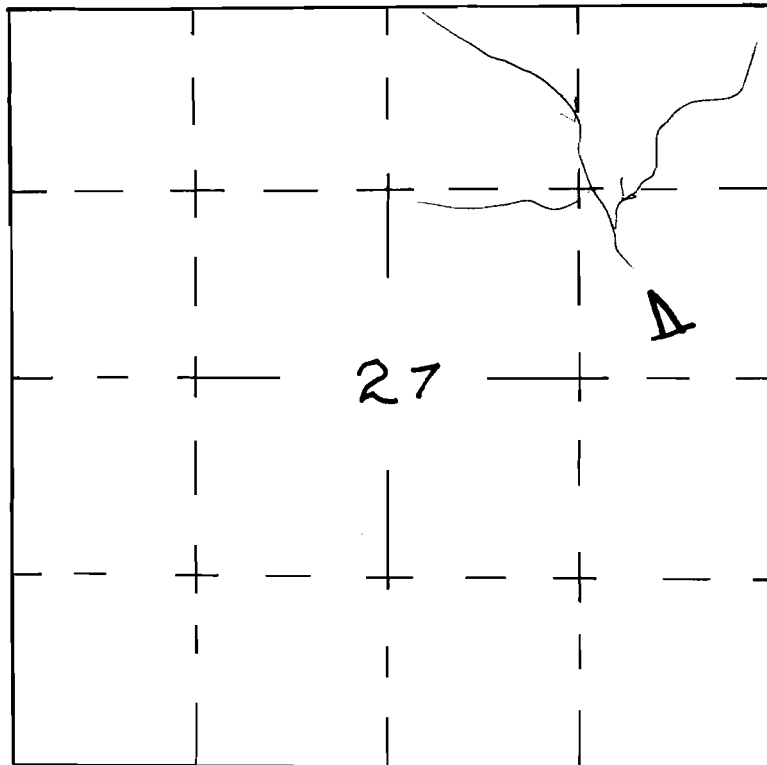

Application No. **R59145**
Permit No. **R 8778**

U. S. DEPARTMENT OF THE INTERIOR
BUREAU OF LAND MANAGEMENT

BIG ARROW

DESIGNED _____	RECOMM. _____
DRAWN _____	RECOMM. _____
CHECKED _____	APPROVED _____
CHIEF, DIV. OF ENG.	

SCALE _____


DATE _____

SHEET _____ OF _____

DRAWING NO. _____

T. 37 S. R. 43 E. W.M.

Actual location
of Big Arrow
Reservoir

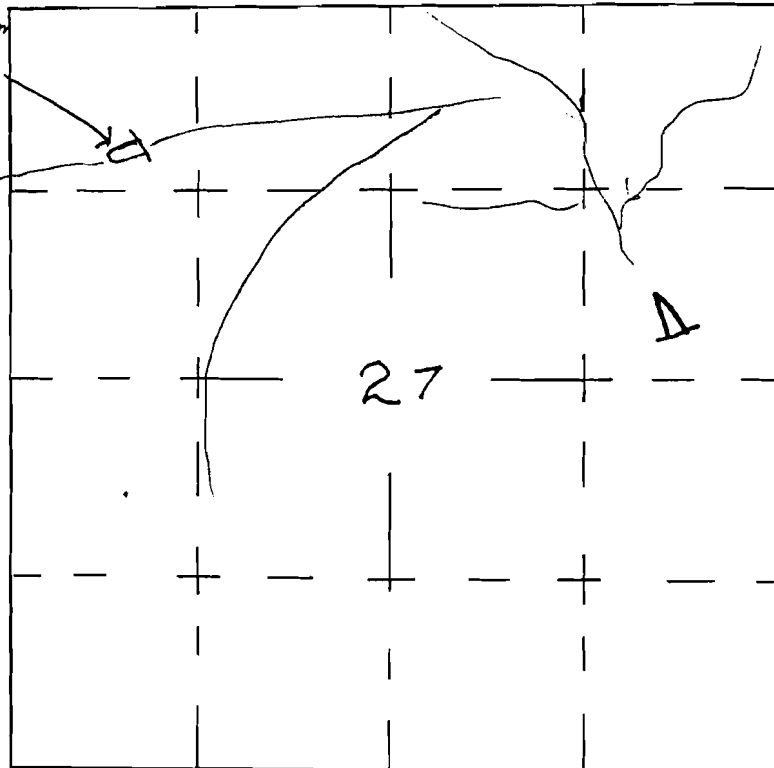

Application No. R59145

Permit No. R 8778

U. S. DEPARTMENT OF THE INTERIOR
BUREAU OF LAND MANAGEMENT

BIG ARROW

DESIGNED _____	RECOMM. _____
DRAWN _____	RECOMM. _____
CHECKED _____	APPROVED _____

CHIEF, DIV. OF ENG.

SCALE _____

DATE _____

SHEET _____ OF _____

DRAWING NO. _____