


UNITED STATES
DEPARTMENT OF THE INTERIOR
BUREAU OF LAND MANAGEMENT

SECTION

Oregon State Water Filings

TOWNSHIP 37S, RANGE 47E, W. M.

North

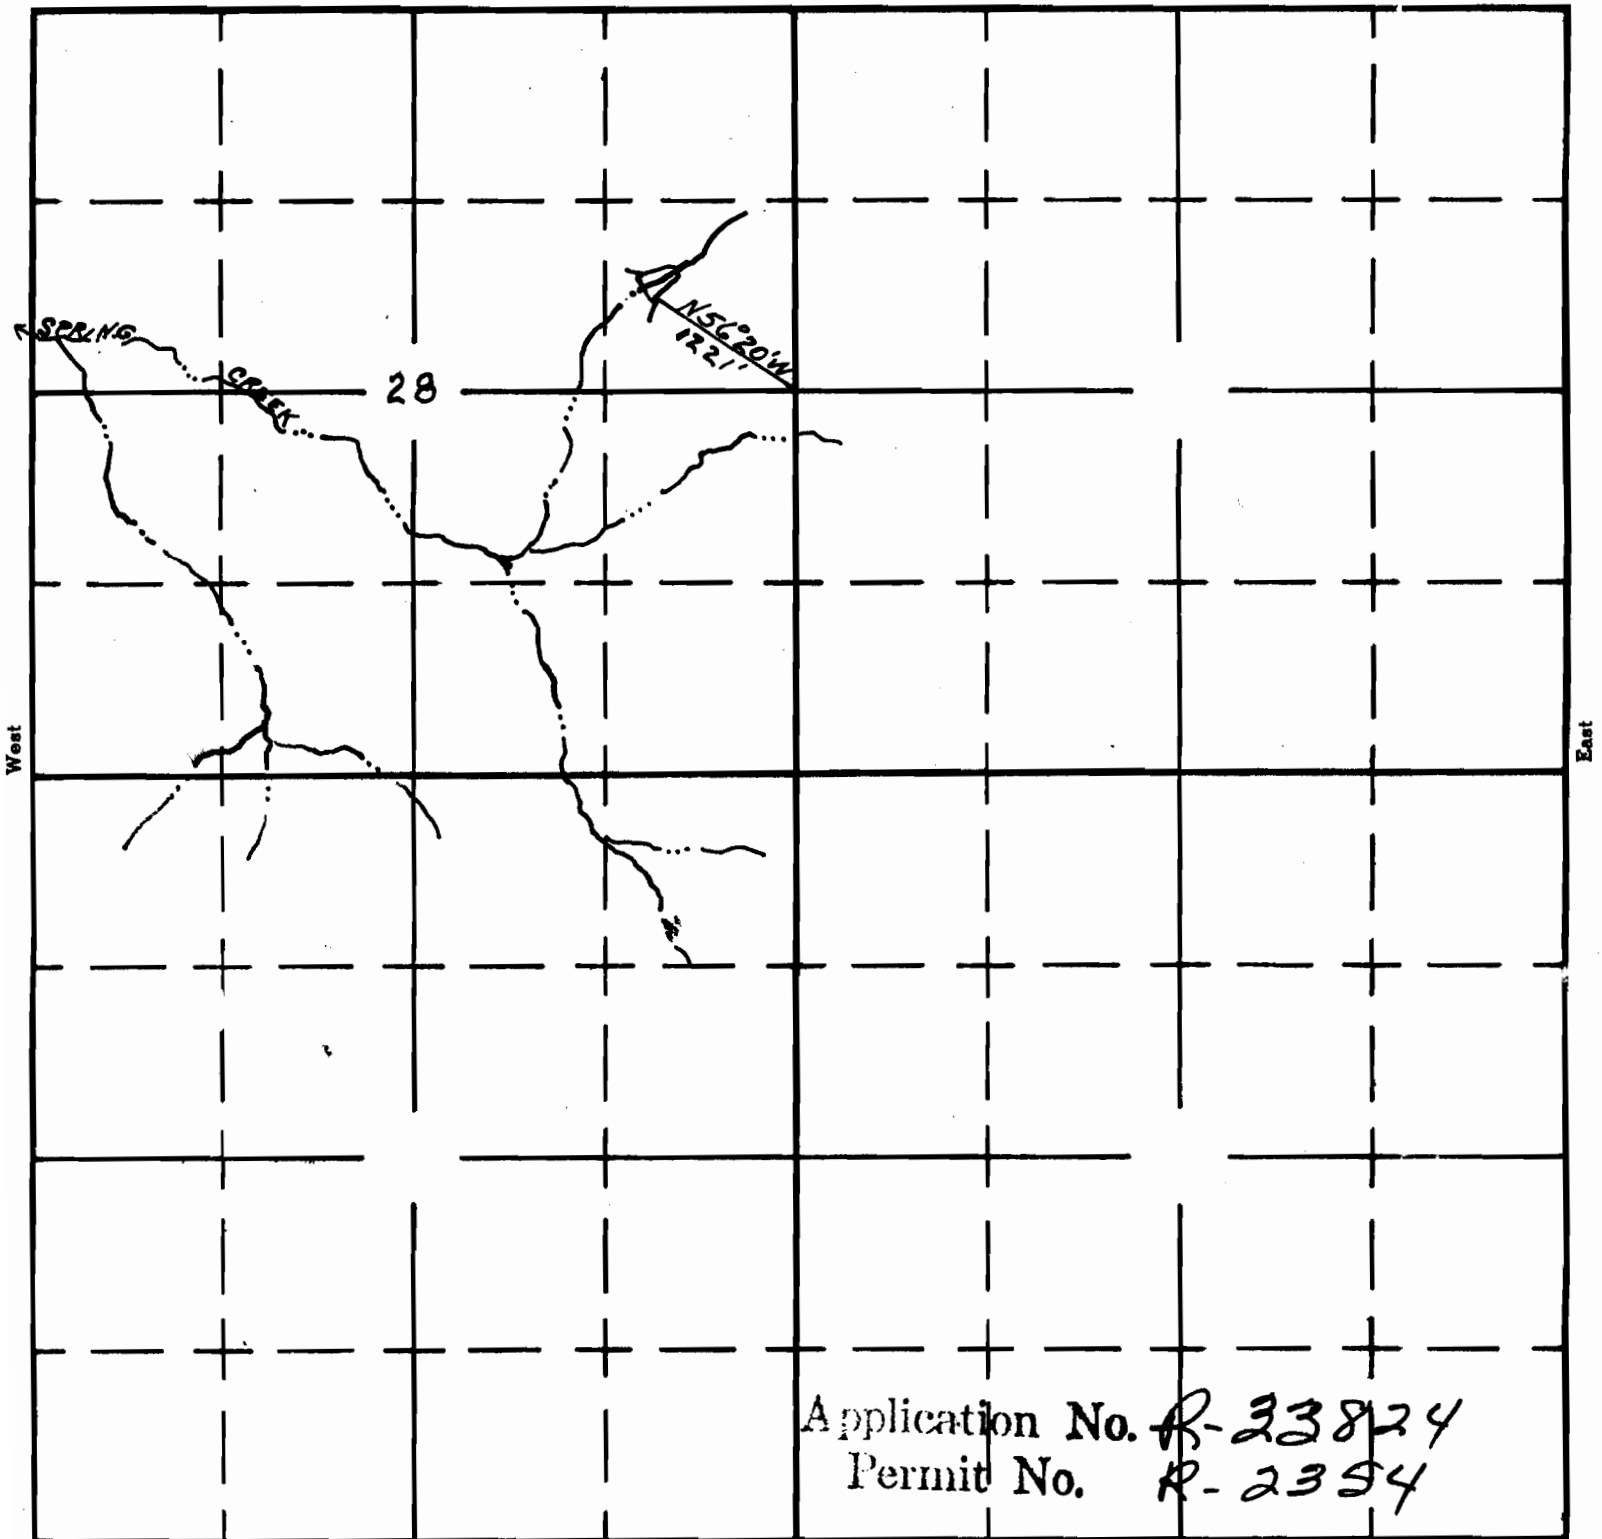

Application No. R-23824
Permit No. R-2354

South

APPLICATION No.

PERMIT No.